


T. 6N. R. 35E. W. M.

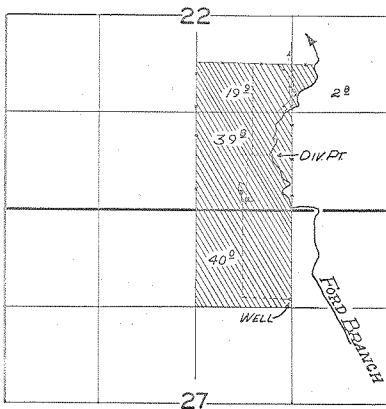

FINAL PROOF SURVEY
UNDER

Application No. G. 714... Permit No. G. 632...
IN NAME OF

..... HERMAN, JOHN MILLER

Surveyed JULY 13 1960, by M. BISH.....