


T.6N.R.34E.W.W.

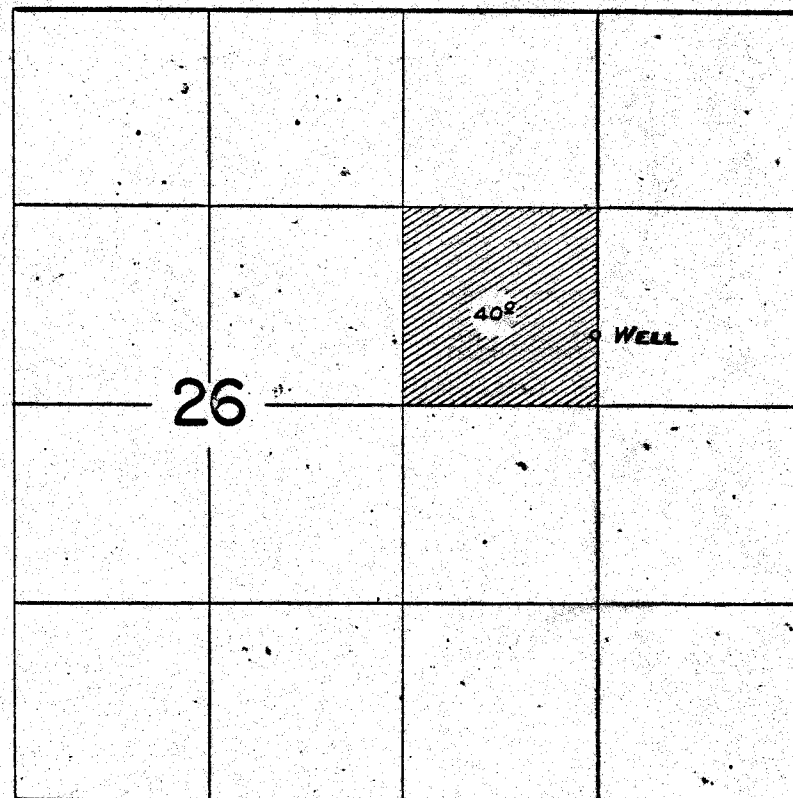

FINAL PROOF SURVEY UNDER

Application No. G-788..... Permit No. G-705.....
IN NAME OF

M. A. BUROKER

Surveyed 18 July 1960, by M. Bish