


T.6N.R.35E.W.M.

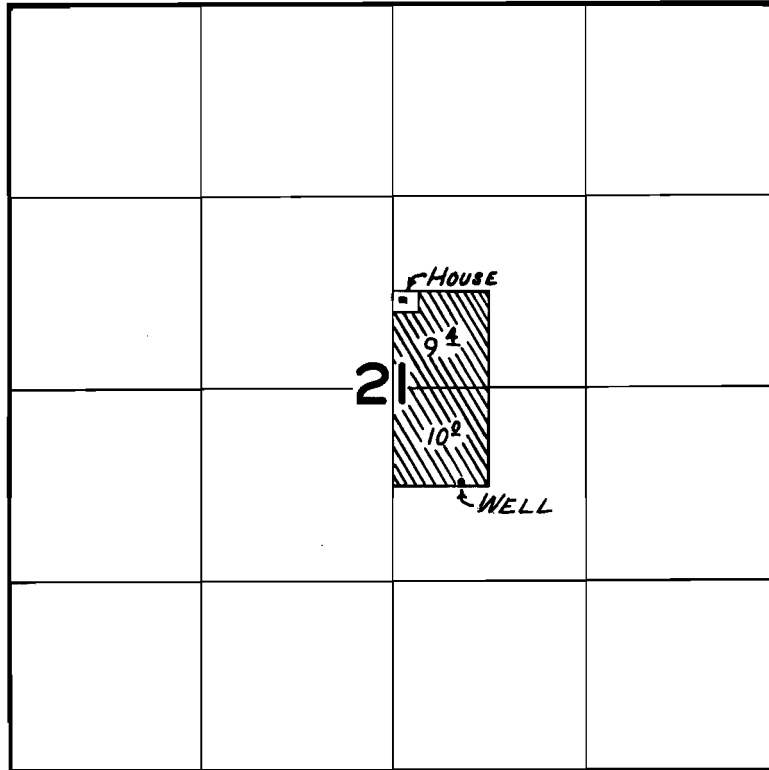

FINAL PROOF SURVEY
UNDER

Application No. *G-957* Permit No. *G-857*
IN NAME OF

J. G. MERRIFIELD

Surveyed *JULY 15 19.60*, by *M. BISH*

NZ-5F-105

MS.