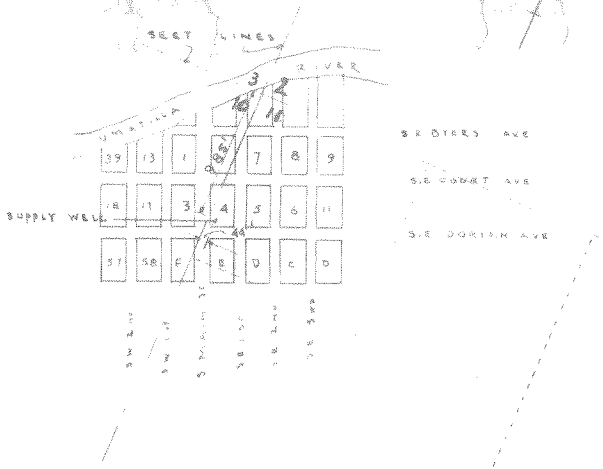

A-1176
P.C. 1056

LEGAL DESCRIPTION
LOT 7, BLK 4 ORIGINAL TOWN
OF PENDLETON UMATILLA COUNTY, OREGON.

WELL LOCATION
FIRST NATIONAL BANK OF O
PENDLETON BRANCH
1" = 715'
SEPT. 15

G-1056
28964
A-1