


G-1184

28965

T.6N.R.35E.W.M.

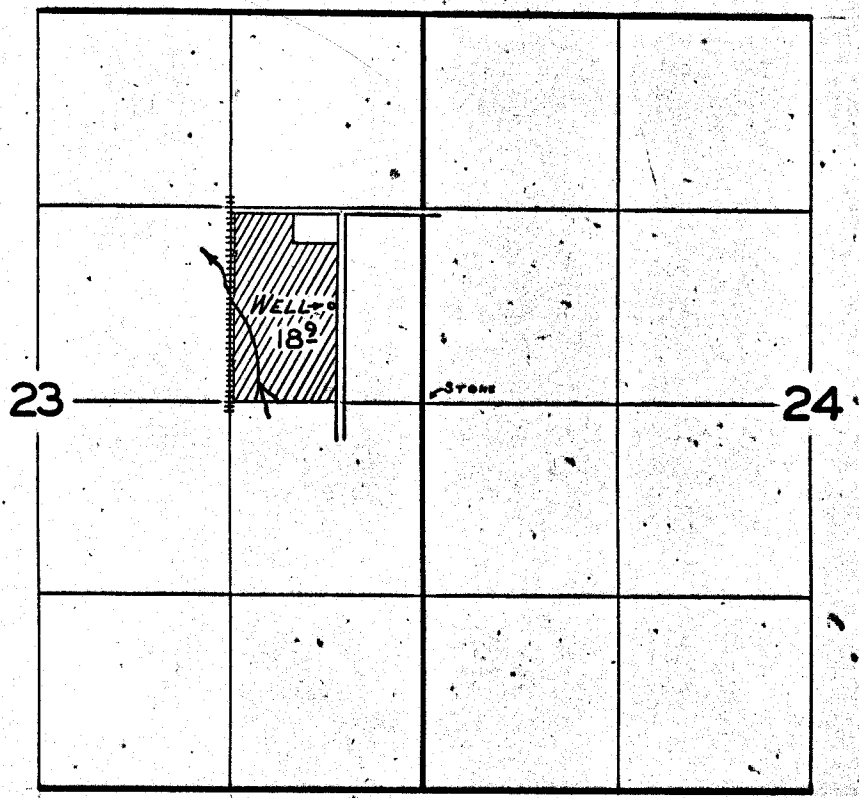

FINAL PROOF SURVEY
UNDER

Application No. *G.1286* Permit No. *G.1184*
IN NAME OF

MARGARET HAUN

Surveyed *JULY 12 1960*, by *M. BISH*

1960-D
NZ-5F-103