


T.5N.R.33E.W.M.

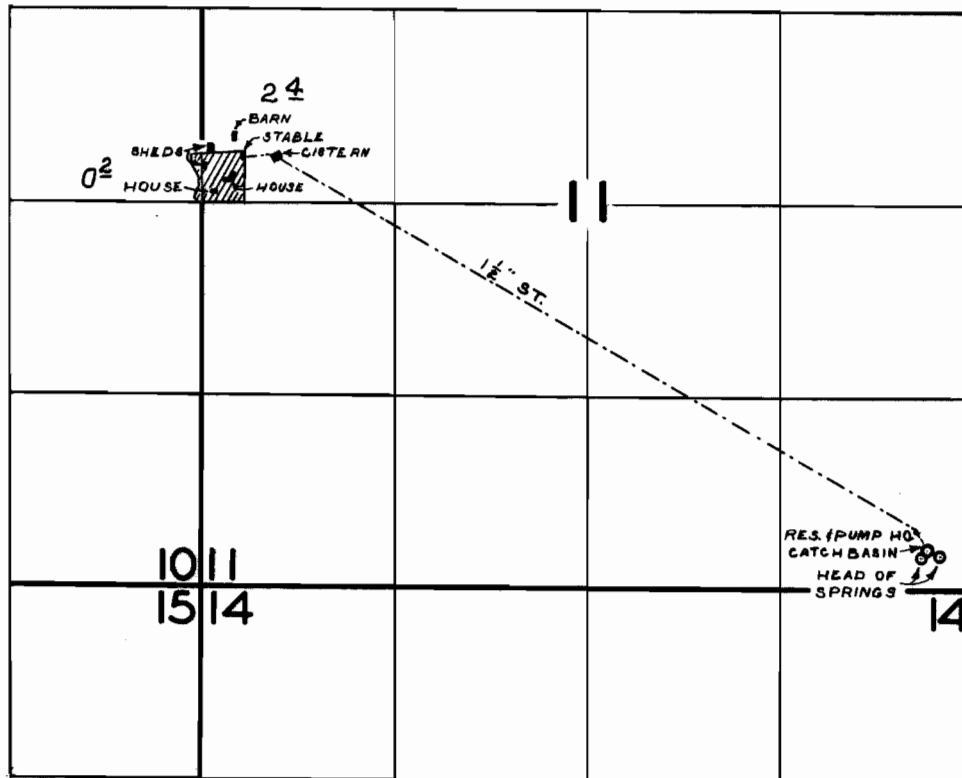

FINAL PROOF SURVEY
UNDER

Application No. 29253... Permit No. 23330...
IN NAME OF

.....*RAPHAEL R. RAYMOND*.....

Surveyed *JULY 21* 1960, by *M. BISH*.....