


T.5N.R. 35E.W.M.

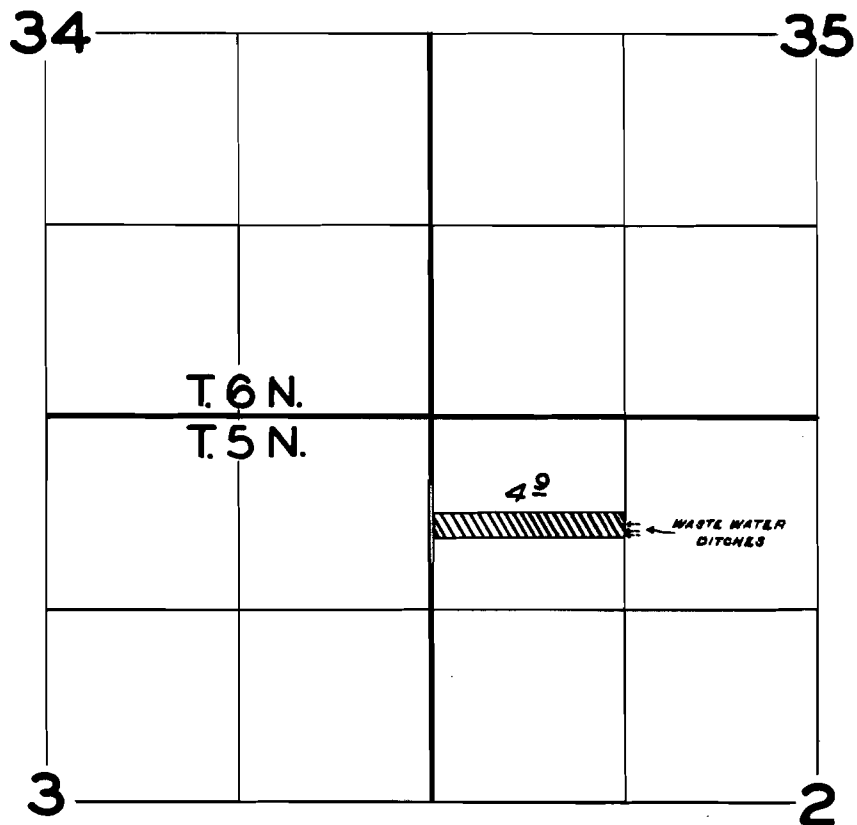

**FINAL PROOF SURVEY**  
UNDER

Application No. 33397 Permit No. 26419  
IN NAME OF

LOUIS & DONALD EGGBRECHT

Surveyed JULY 13 1960, by M. BISH