


T. 2S. R. 2W. W.M.

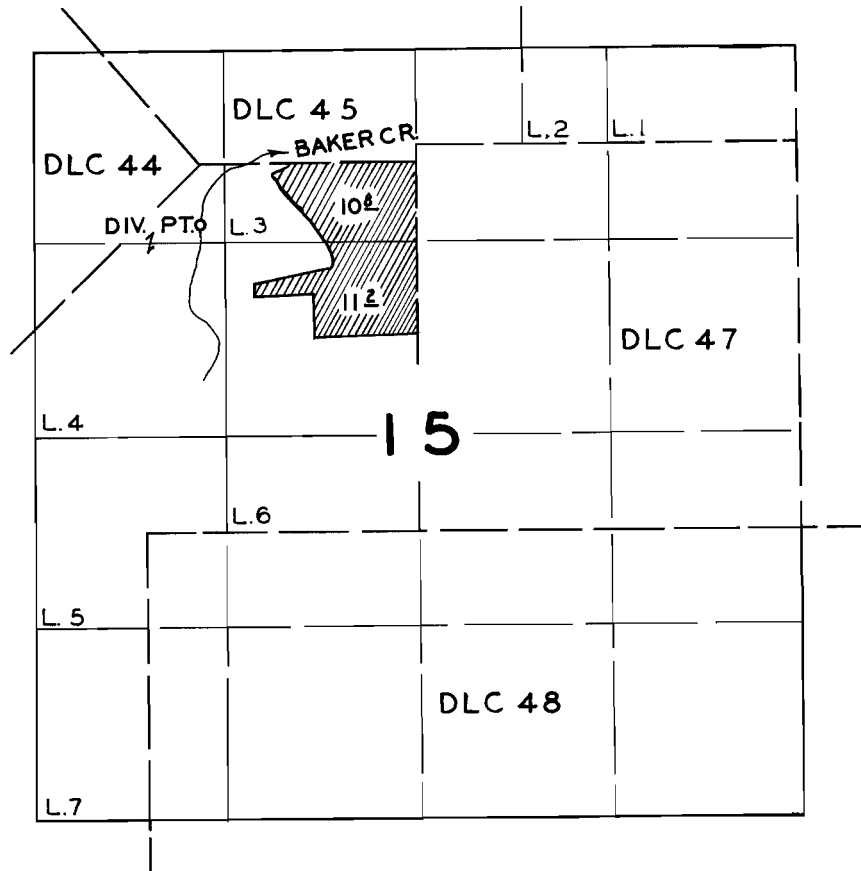

FINAL PROOF SURVEY
UNDER

Application No. 27593 Permit No. 21738

IN NAME OF

K. T. LOUIS

Surveyed SEPT. 16, 1959, by C. O. BARTELS
MAY 24, 1960, R. H. JACKSON