


T.2S. R.2W.W.M.

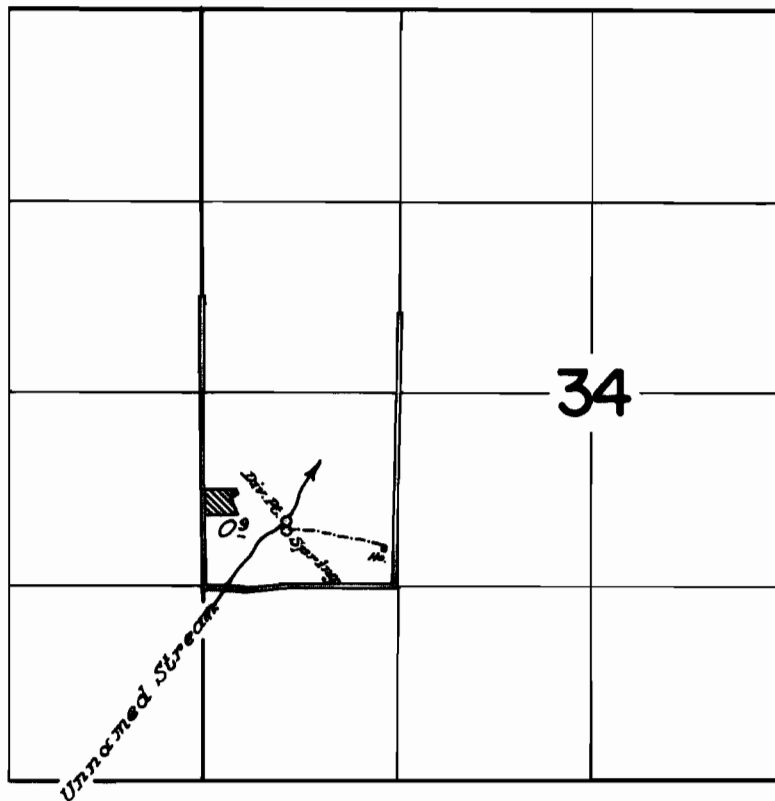

FINAL PROOF SURVEY
UNDER

Application No. 27981 Permit No. 22024
IN NAME OF

LAWRENCE L. AVERY

Surveyed May 23 1960, by

[Signature]