


# T.1N. R.4W.W.M.

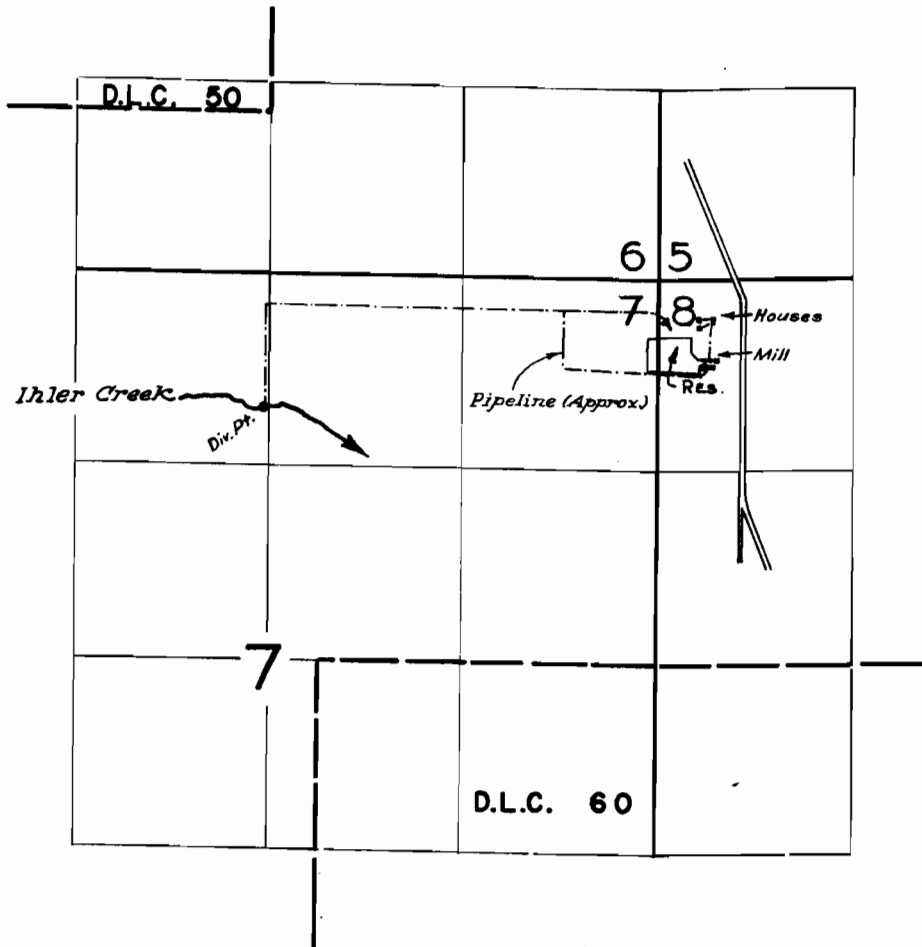

## FINAL PROOF SURVEY UNDER

*R-28542*      *R-1497*  
Application No. *27923* Permit No. *22106*  
IN NAME OF

**Joe & Alice Dober**

Surveyed *August 4* 19*60*, by *L. Jackson*