


T.1N. R.4 W.W.M.

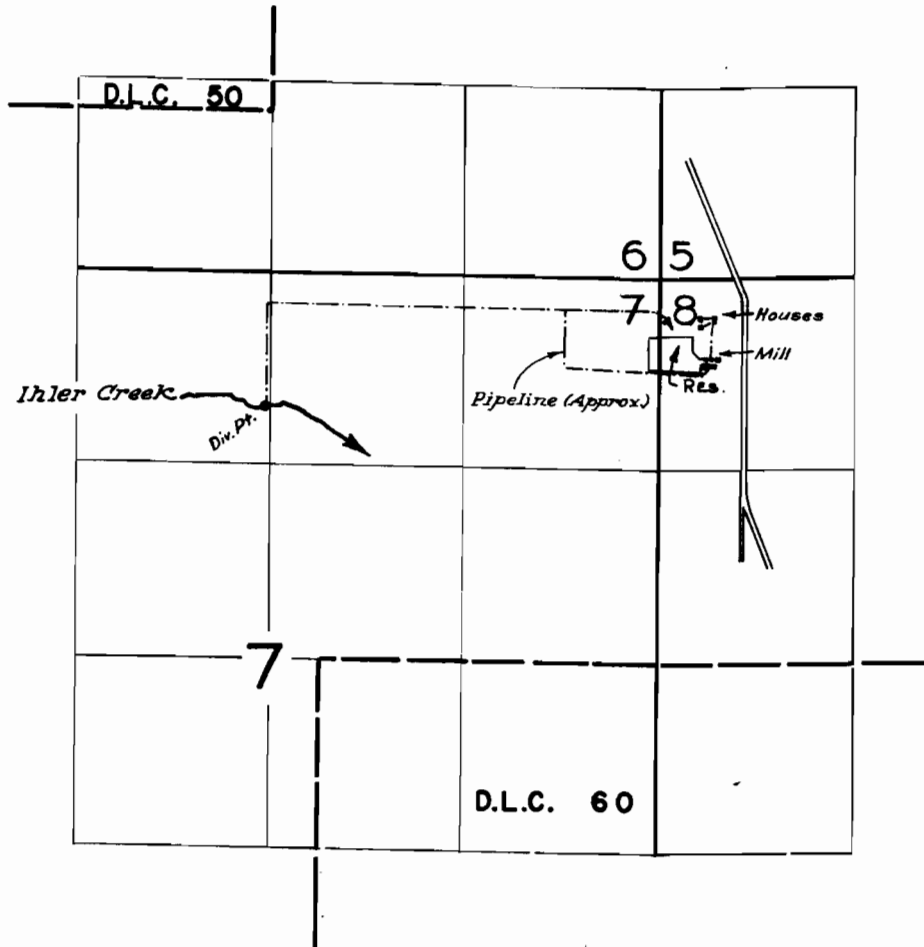

FINAL PROOF SURVEY UNDER

R-28542 *R-1497*
Application No. *27923* Permit No. *22106*
IN NAME OF

Joe & Alice Dober

Surveyed *August 4* 19*60*, by *L. Jackson*