


T.2S.R.2W.W.M.

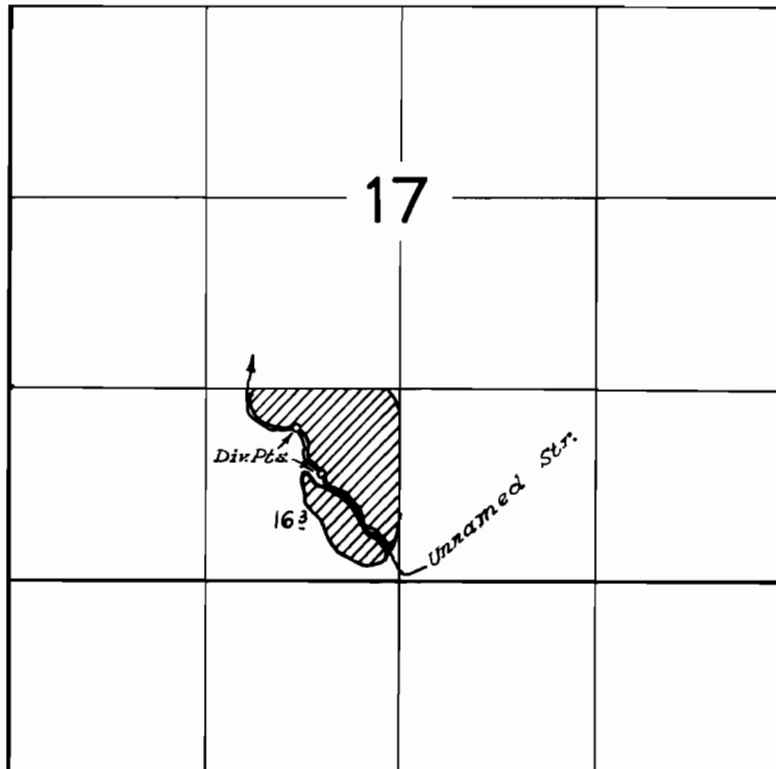

FINAL PROOF SURVEY
UNDER

Application No. 28475. Permit No. 22301.
IN NAME OF

EVERETT C. DIXON

Surveyed July 8, 1960, by *[Signature]*