


T.3N. R.3W.W.M.

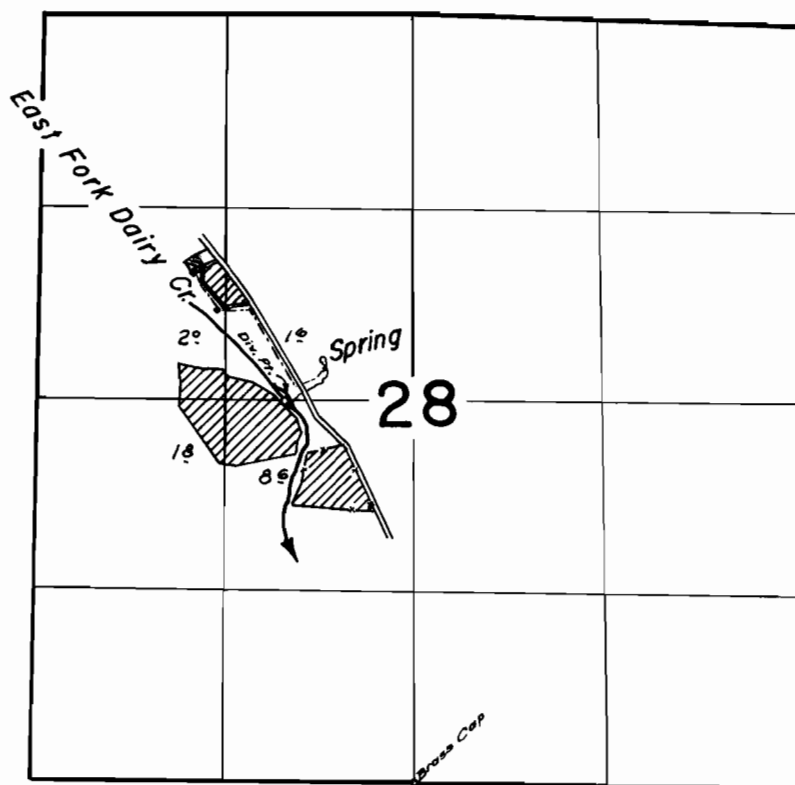

FINAL PROOF SURVEY
UNDER

Application No. 28834 22688
30285 Permit No. 23850
IN NAME OF

Dale M. & Dorothy B. Pfeiffer

Surveyed August 1, 1960, by [Signature]