


T.3 S.R.3 W.W.M.

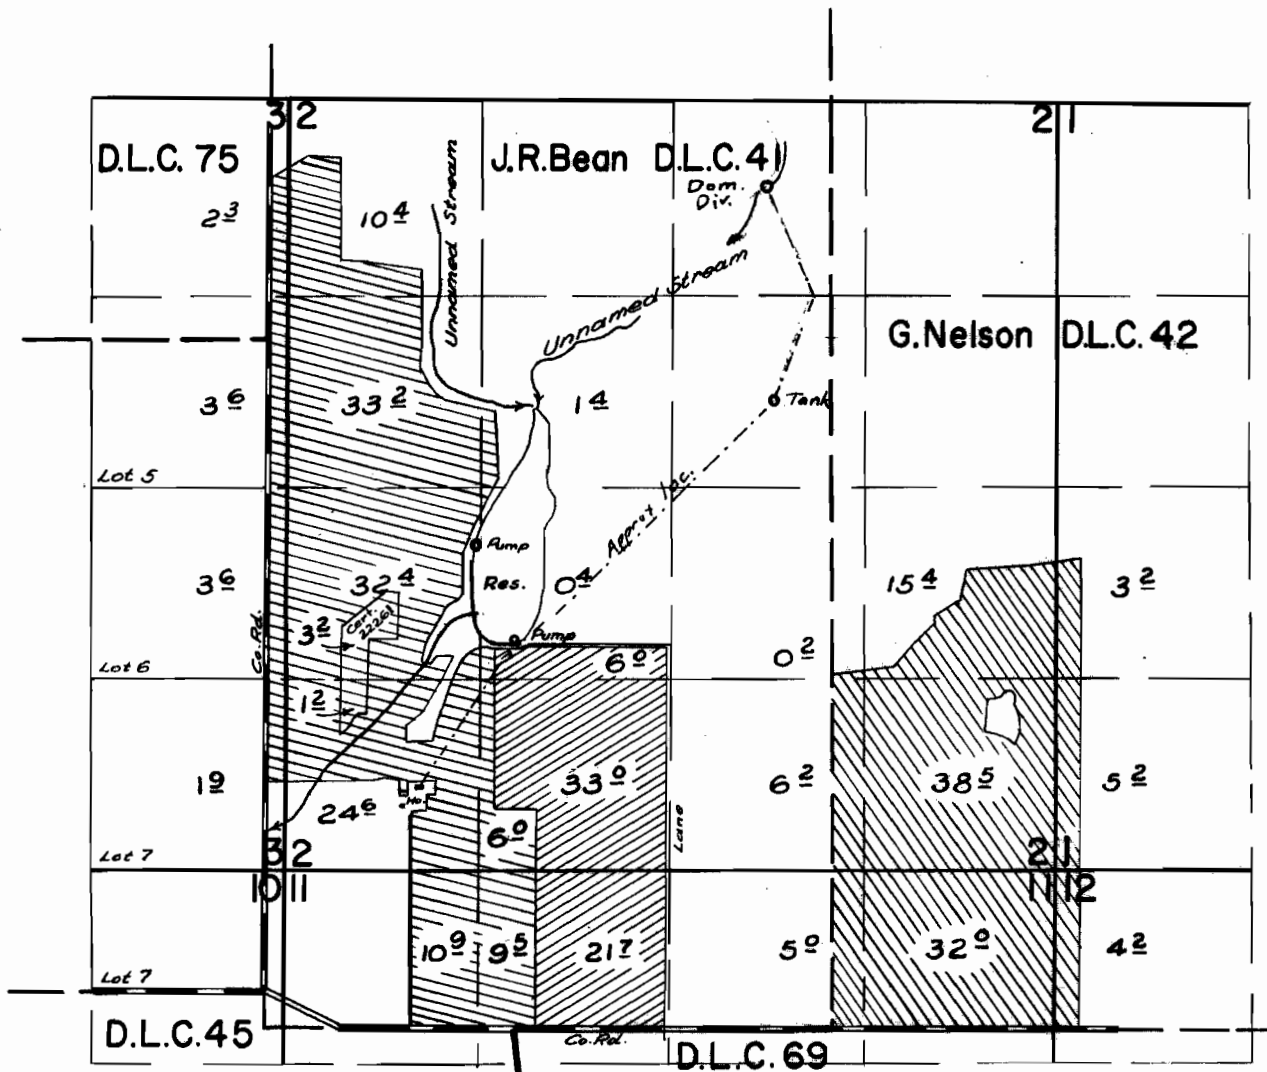

FINAL PROOF SURVEY UNDER

R-25833	R-1407
25834	21656
R-28748	R-1560
28749	22616
R-29637	R-1761
29638	23676
	24269

Application No. 30831..... Permit No.
IN NAME OF

R. L. WALKER

Surveyed 13 Mar. 1960, by M. B. Bish