


to of me doing all Ditch' under application
 of phosphate water & to permit to take) from
 township 14 south Range 30; 8; N. W. 4 *

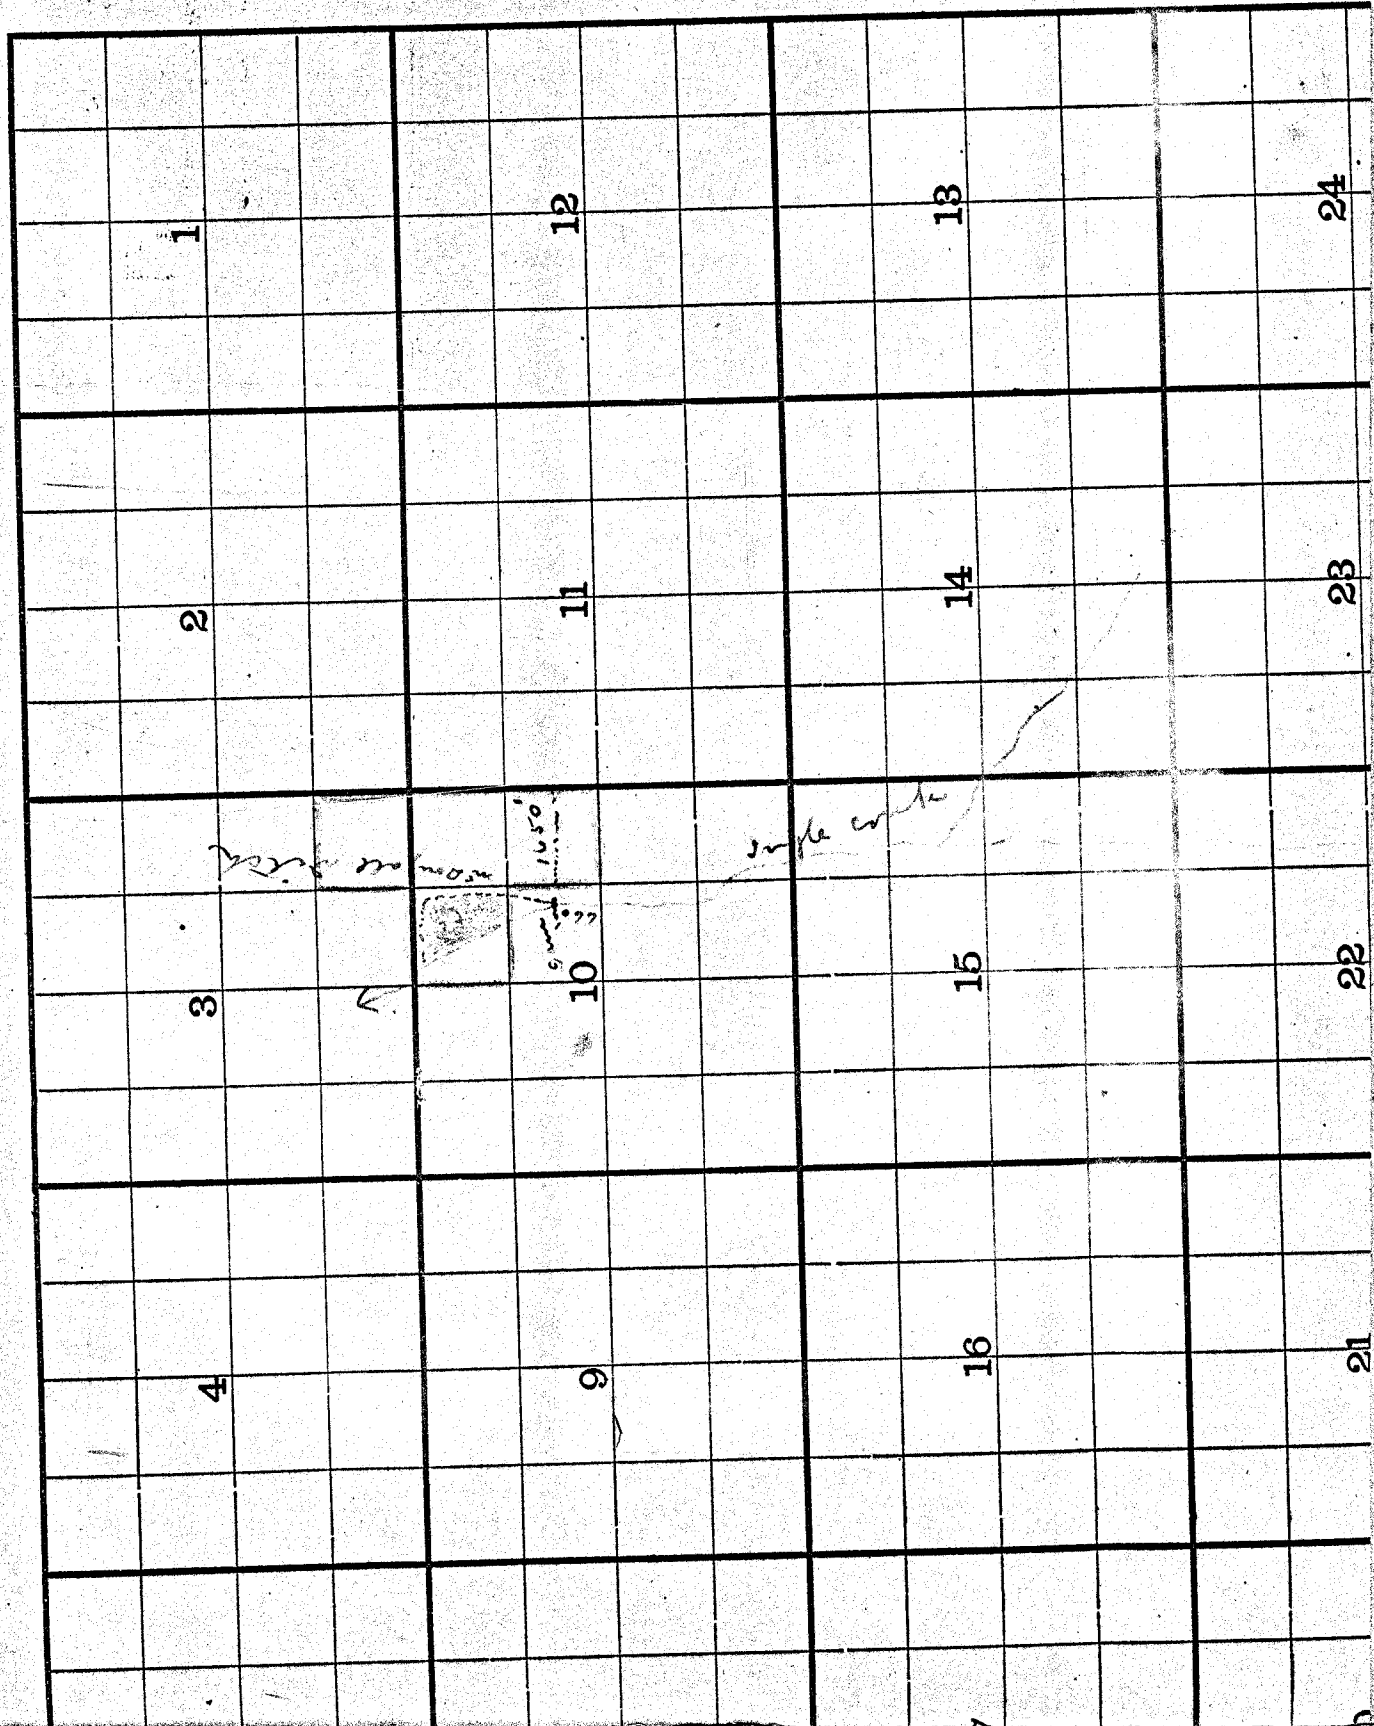

single creek
 1050
 1050

1050 7043

Rev. 4412

Rev # 11412
 2900