


T. 23 S. R. 30 E. W.M.

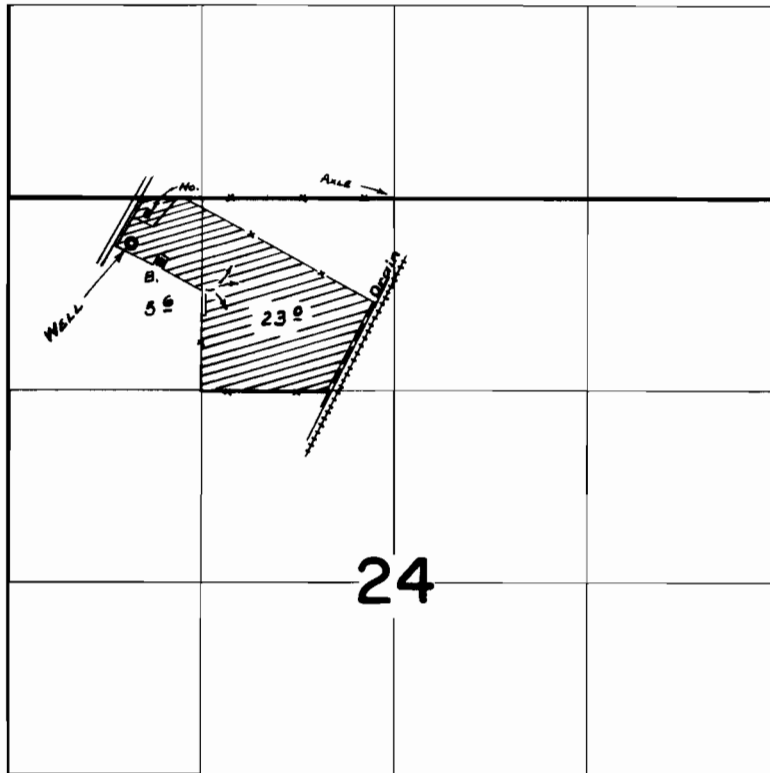

**FINAL PROOF SURVEY**  
UNDER

Application No. *G-695* Permit No. *G-643*  
IN NAME OF

*RALPH and ELIZABETH CHRISTENSEN*

Surveyed *18 Oct.* 19*60*, by *P. Jackson*