



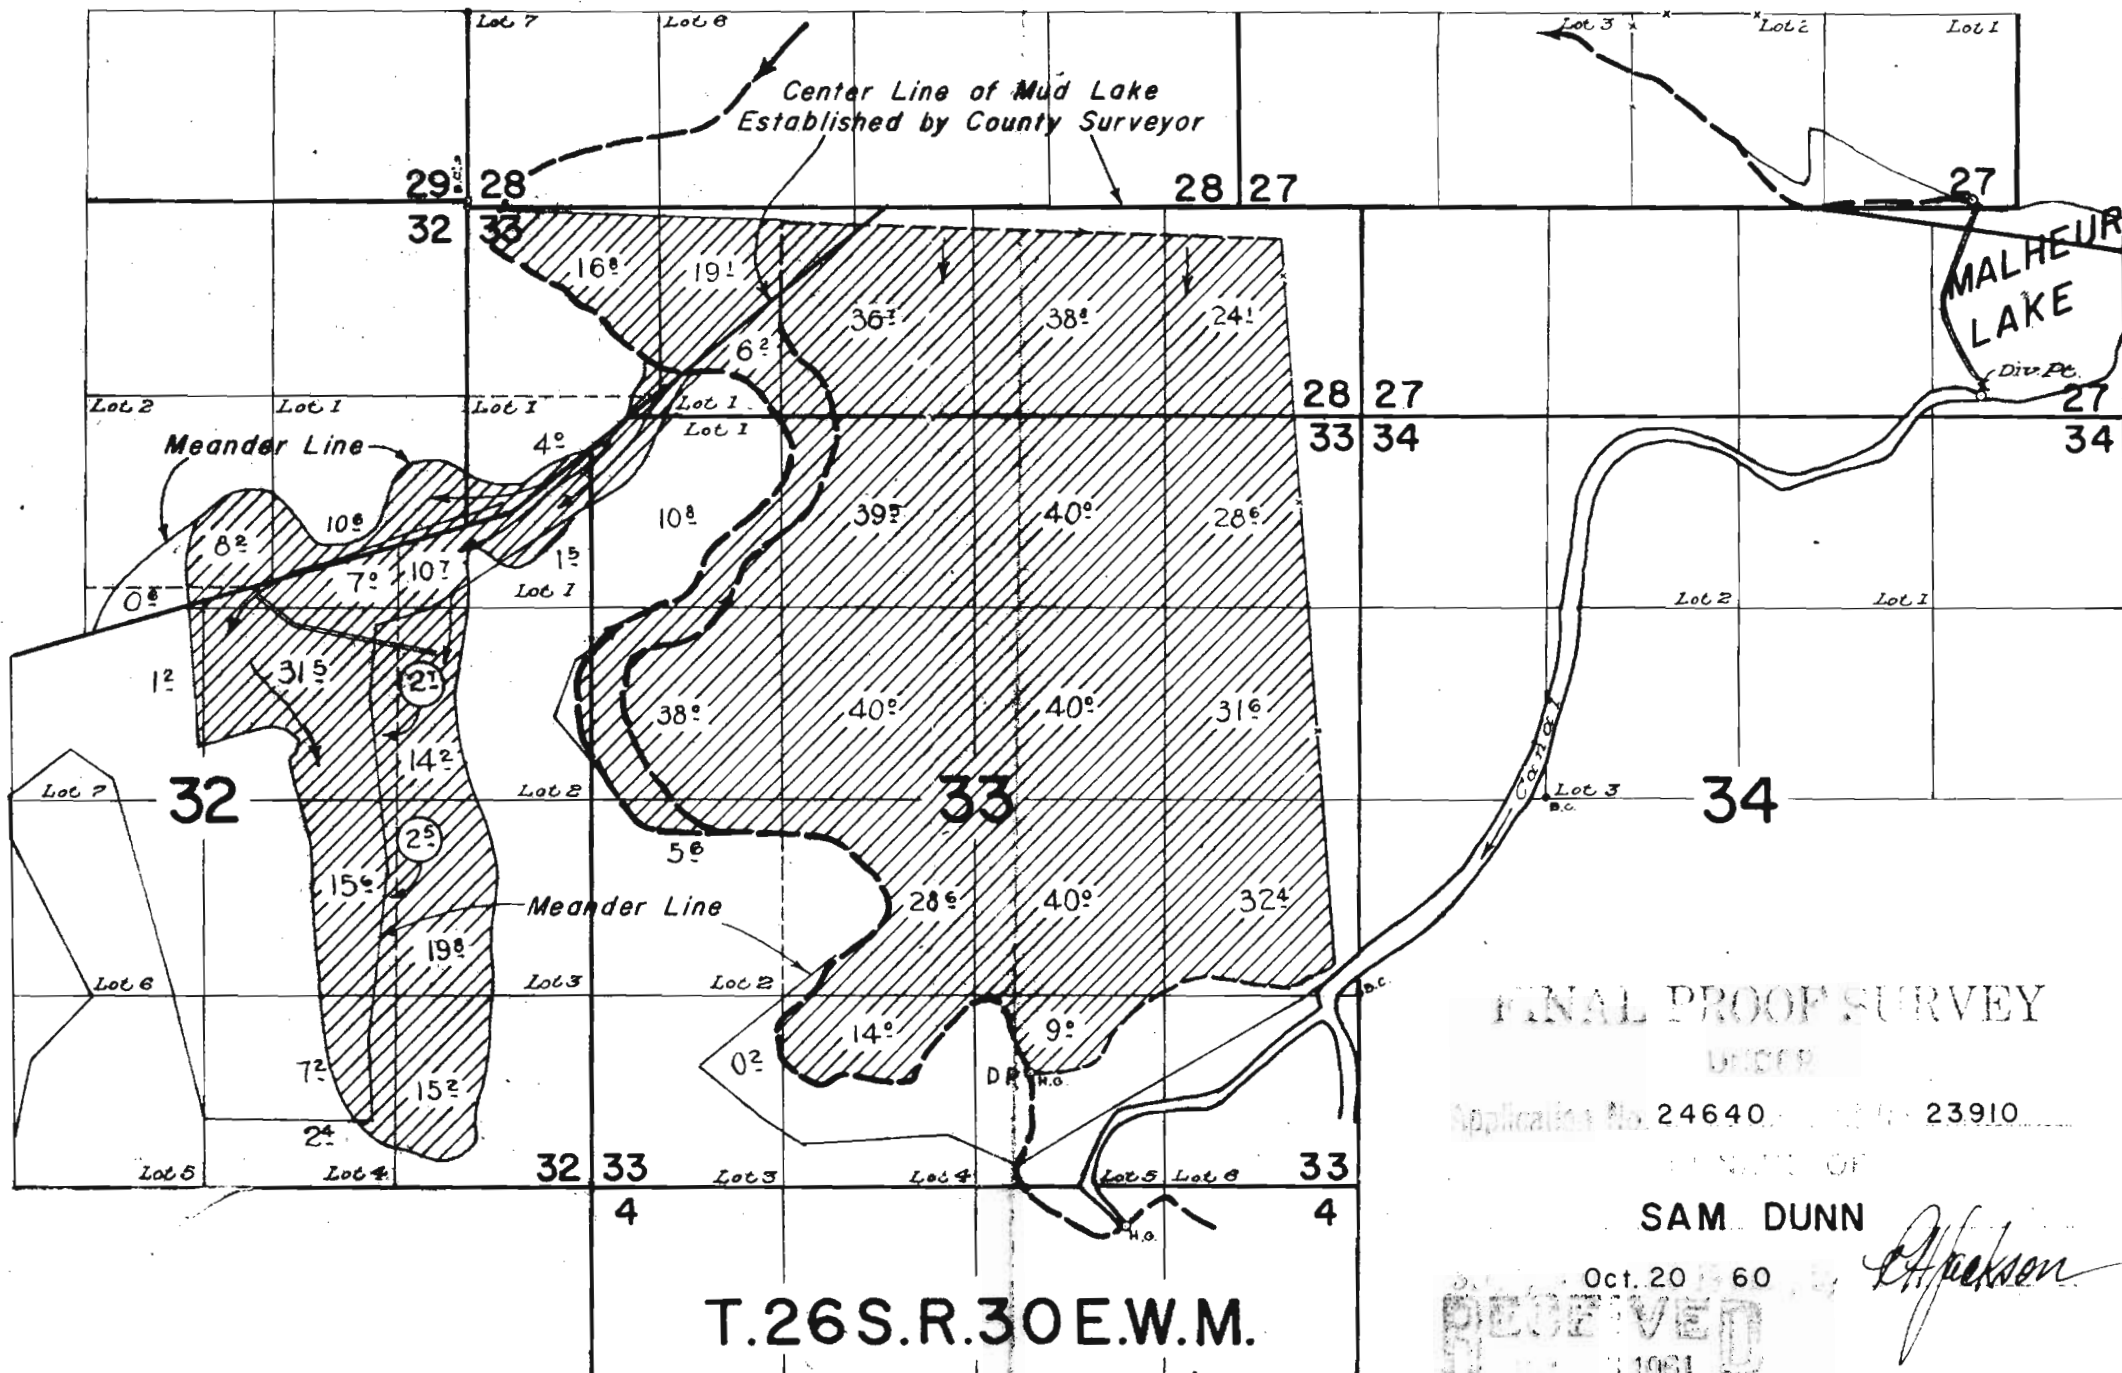

FINAL PROOF SURVEY

UNDER

Application No. 24640 and 23910

IN FAVOR OF

SAM DUNN

Oct. 20 1960

RECEIVED
1961

C. Jackson