


Operator Daniel B. Pierson

A.C.P. Farm No. _____

County Hood River

Section 9 Township 2 N Range 10 E Aerial Photo No. BAZ-A-1M-124

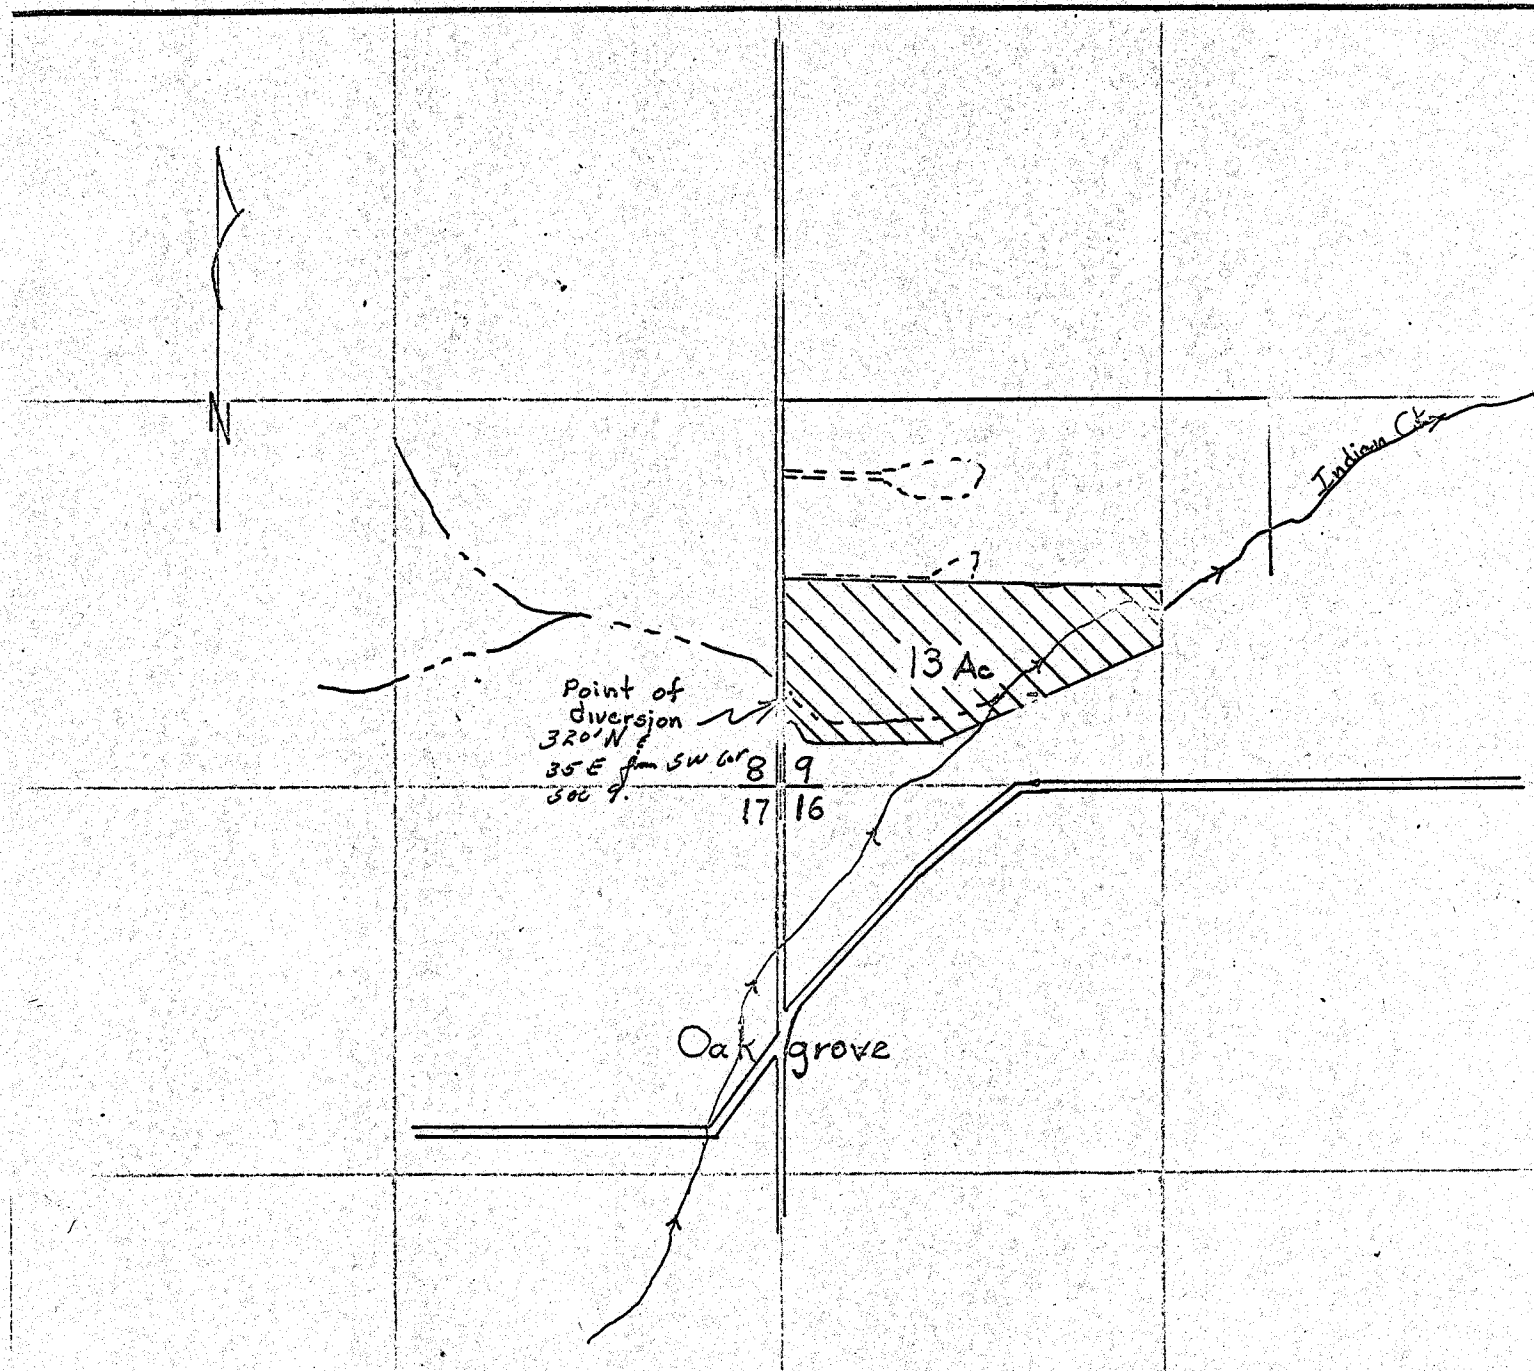

Application No. 33509
Permit No. 26551