


T. 36 S., R. 3 W., W.M.

RECORDED
INDEXED
MAY 11 1961
COUNTY CLERK
WALLA WA COUNTY

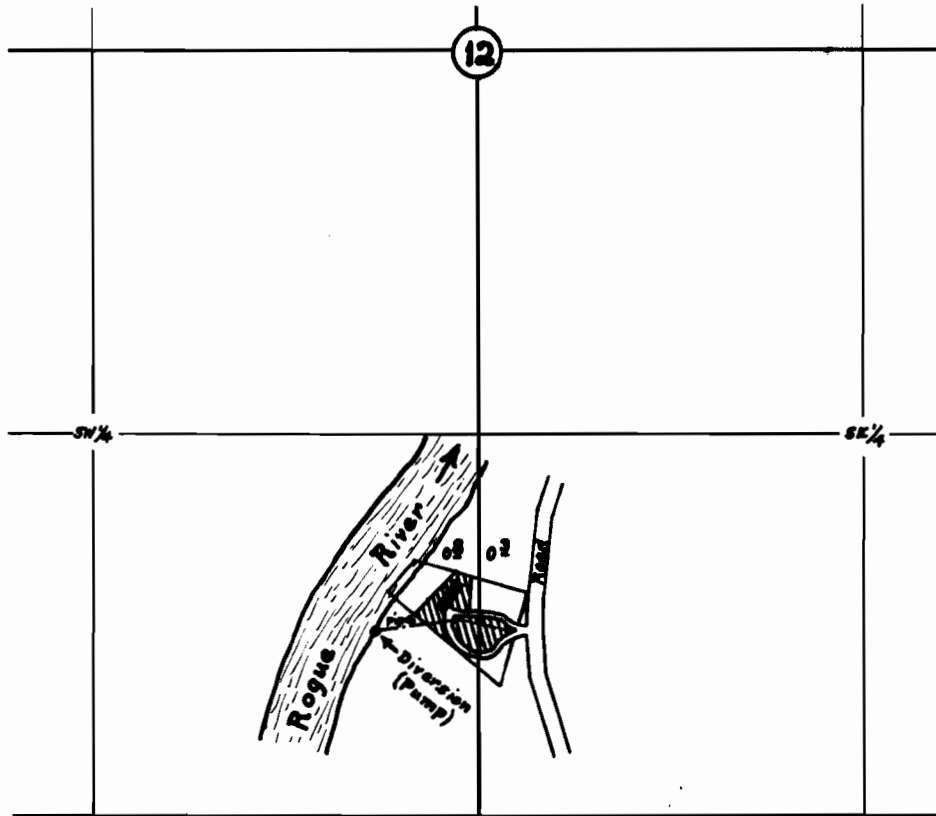

FINAL PROOF SURVEY
UNDER

Application No. 30041..... Permit No. 23687.....
IN NAME OF

.....Jennings Pierce.....

Surveyed April 14 1961., by D. L. Handrick.....

Scale: 8" = 1 mile

Plane Table Survey