



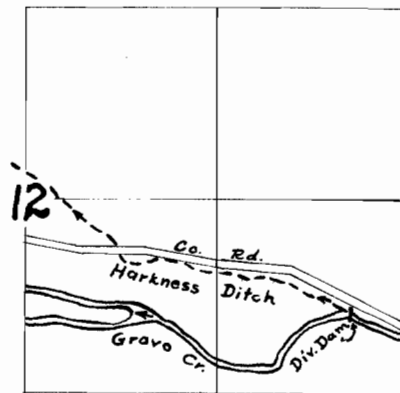

T. 34 S. R. 6 W. W.M.

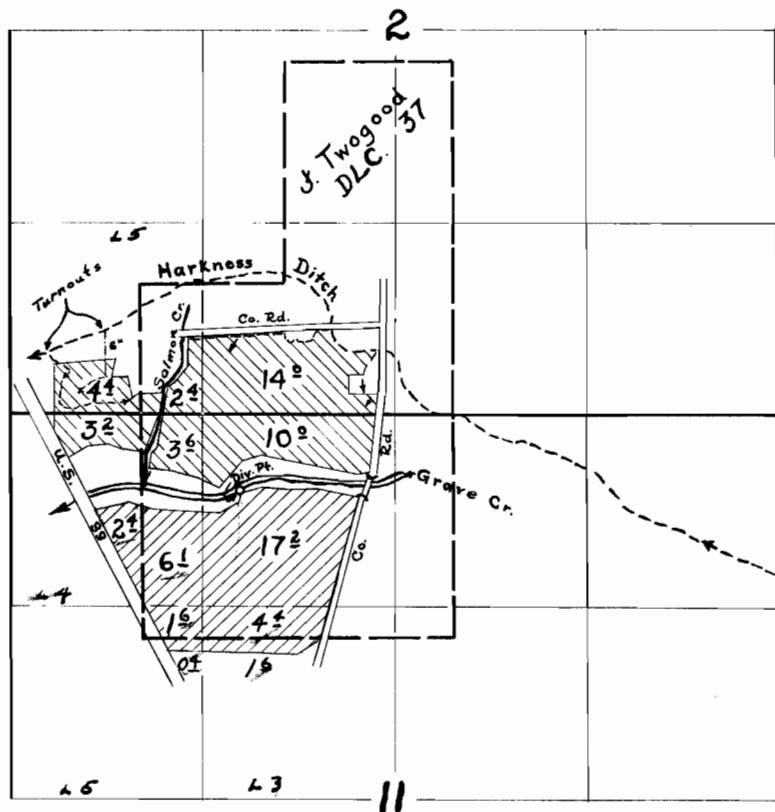

FINAL PROOF SURVEY
UNDER

Application No. 29623 Permit No. 23335 
Application No. 29625 Permit No. 23337 

IN NAME OF
Genevieve Price
Frank E. Price

Surveyed *19 May 1959*, by *C. O. Bartels*