


# T 38 S. R. 20 E. W. M.

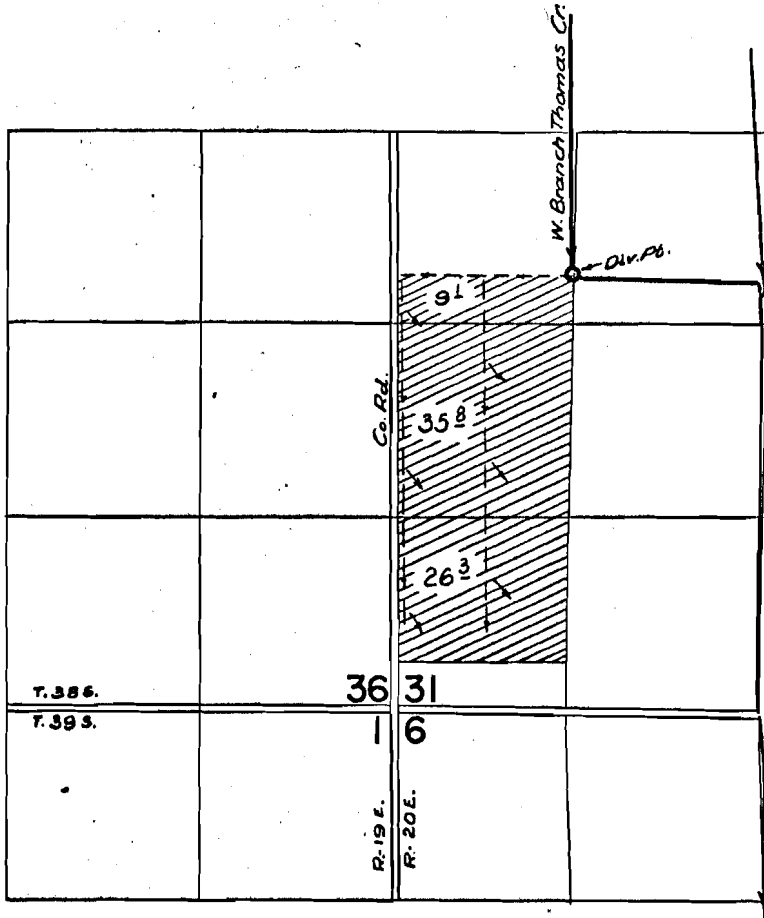

## FINAL PROOF SURVEY UNDER

Application No. 31496 Permit No. 25070  
IN NAME OF

ERWIN ABRAMSON

Surveyed 1 Nov. 1960, by R. JACKSON

38-20 ✓

CHZ-38K-120