


T. 9 S. R. 1 W. W. M.

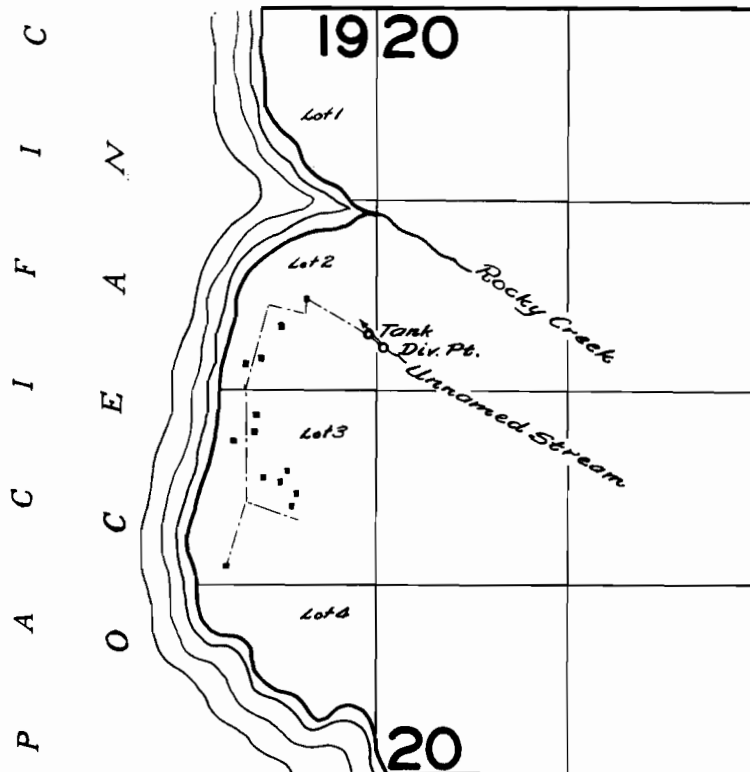

FINAL PROOF SURVEY
UNDER

Application No. 21123 Permit No. 16553
IN NAME OF

MIROCO Co.

Surveyed April 16 1959, by C. B. Smith