


NOTE: WATER SYSTEM TO BE ENLARGED BEFORE USED IN THIS AREA.

I, DAVID J. NEW OF WALLA WALLA, WASHINGTON, DO HEREBY CERTIFY THAT THIS MAP WAS MADE FROM NOTES TAKEN DURING AN ACTUAL SURVEY MADE UNDER MY IMMEDIATE SUPERVISION ON MAY 18, 1957.

David J. New

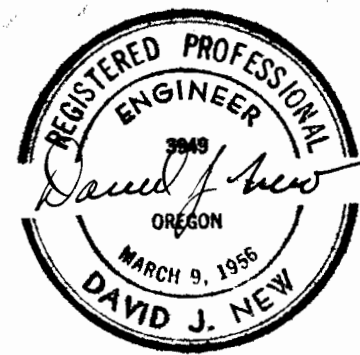

LEGEND
 -x- - 2" WATER LINE

SILETZ TRACT

ROBIN REED TRACT
 SEC. 13 TWP. 8S., R. 11 W. 1/4 M.
 LINCOLN COUNTY, OREGON.
 SCALE: 1" = 100'
 DRAWN: L.E.F. CHECKED: D.J.N.

Application No. R-31494 & 31495
 Permit No. R-2035 & 24958