

1/4 Cor. Section 1 - T.145 R.12N W.M.

South 752.3  
West line of Gov't Lot 2




Gov't Lot 2 - Sec 1  
Twp 145. R.12N W.M.

West 1/2 Gov't Lot 2

Scale: 1" = 200'

*John C. Adams*  
12/14/51

East line Lot 2

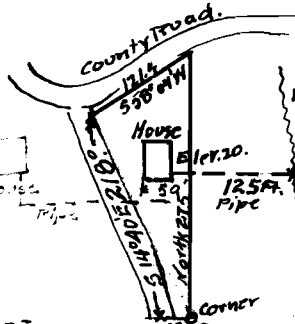

East 325.4

SE Corner of Property  
South 752.3  
East 325.4 From North 1/4 Cor. of Section 1

South 597.80 From N 1/4 Cor. SPC 1 - T.145 R.12N W.M.  
East 482.93

South line Lot 2

Application No. 31770  
Permit No. 25280