


T.9S.R.2E.W.M.

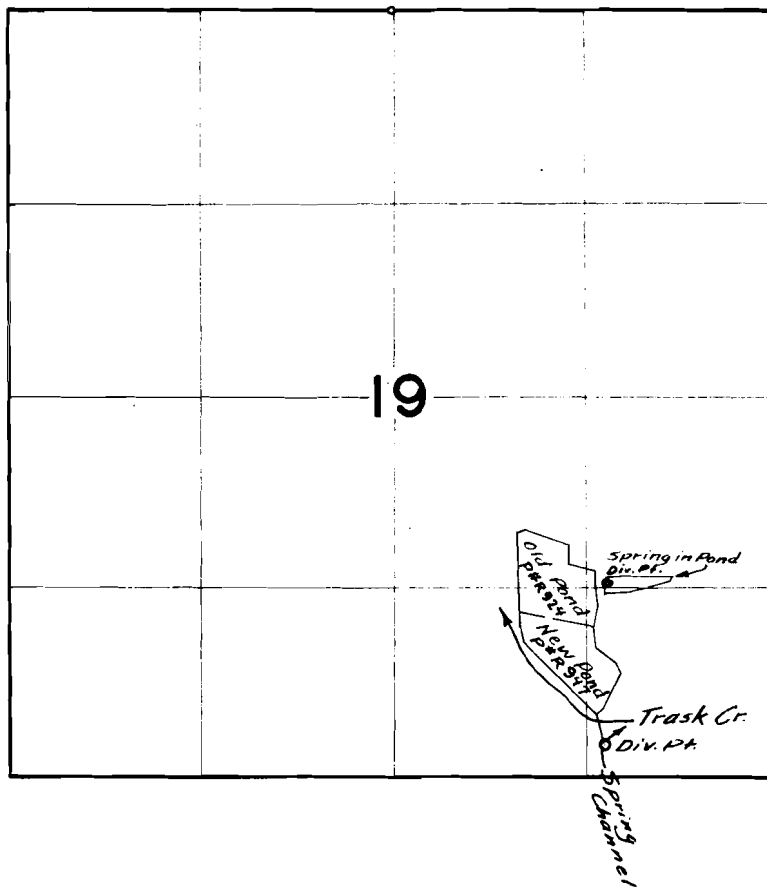

FRERES LUMBER CO.

R- 29867 + 29864
A- 2552 + 27047

R 29867
29864