


T. 5S. R. 10W. W.M.

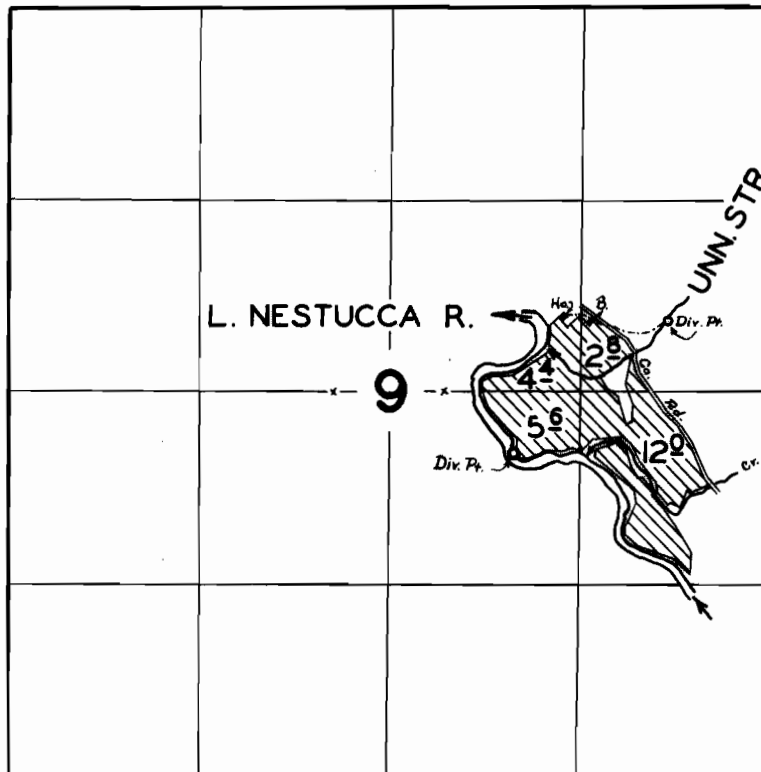

FINAL PROOF SURVEY
UNDER

Application No. 29149 Permit No. 22985
IN NAME OF

LENTHAL CONLEE

Surveyed APR. 22 1959, by M. BISH