


T.7S. R.44E.W.M.

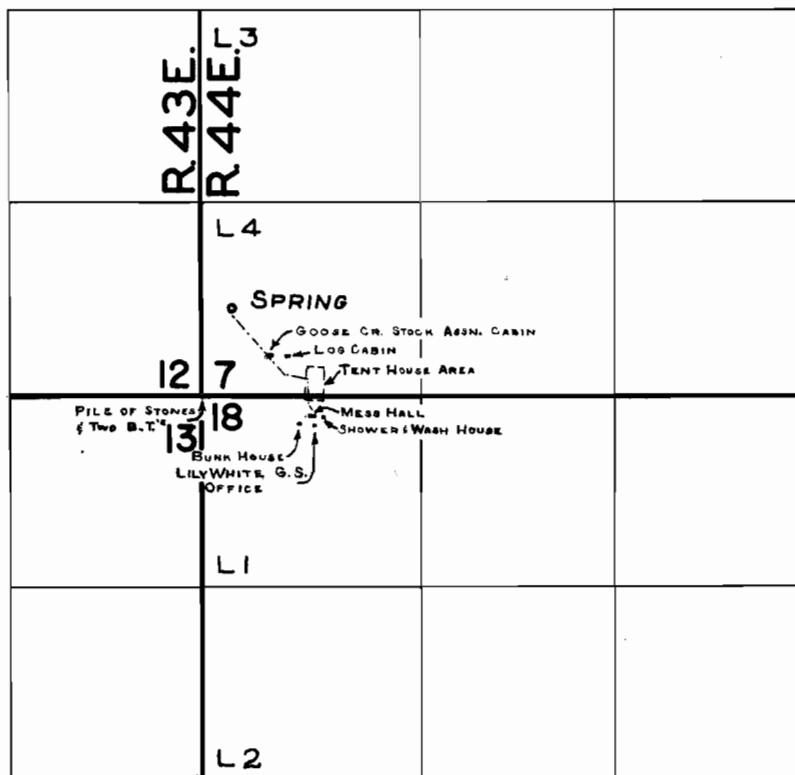

FINAL PROOF SURVEY
UNDER

Application No. 17,916 Permit No. 13,602
IN NAME OF

U. S. FOREST SERVICE

Surveyed SEPT. 21 1960, by M. BISH