


T.9S.R.39E.W.W.

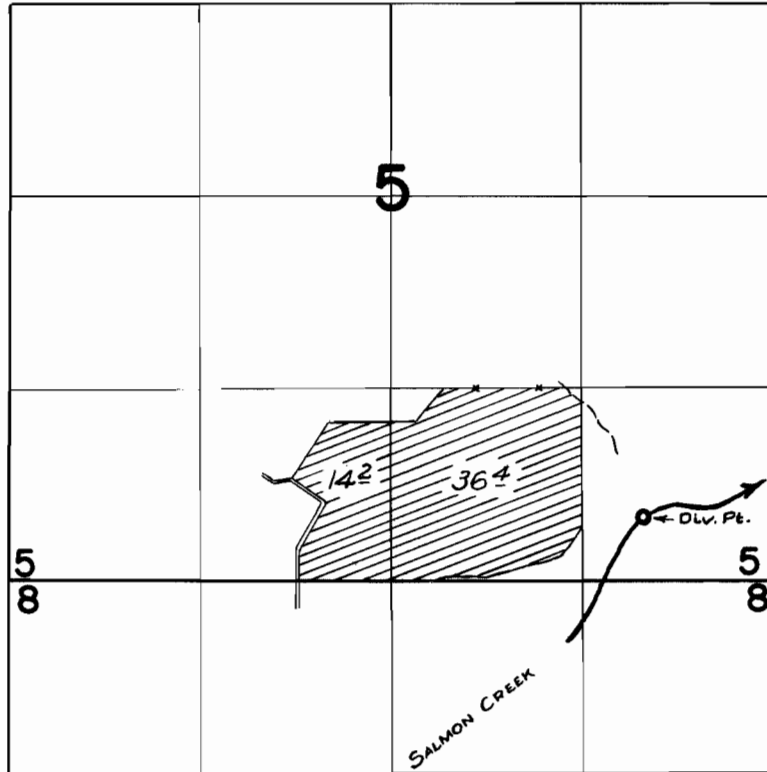

FINAL PROOF SURVEY UNDER

Application No. 28159 Permit No. 22160
IN NAME OF

ELMER SATTERBERG

Surveyed 20 Sept. 1960, by R. JACKSON