


T.7S.R.39E.W.M.

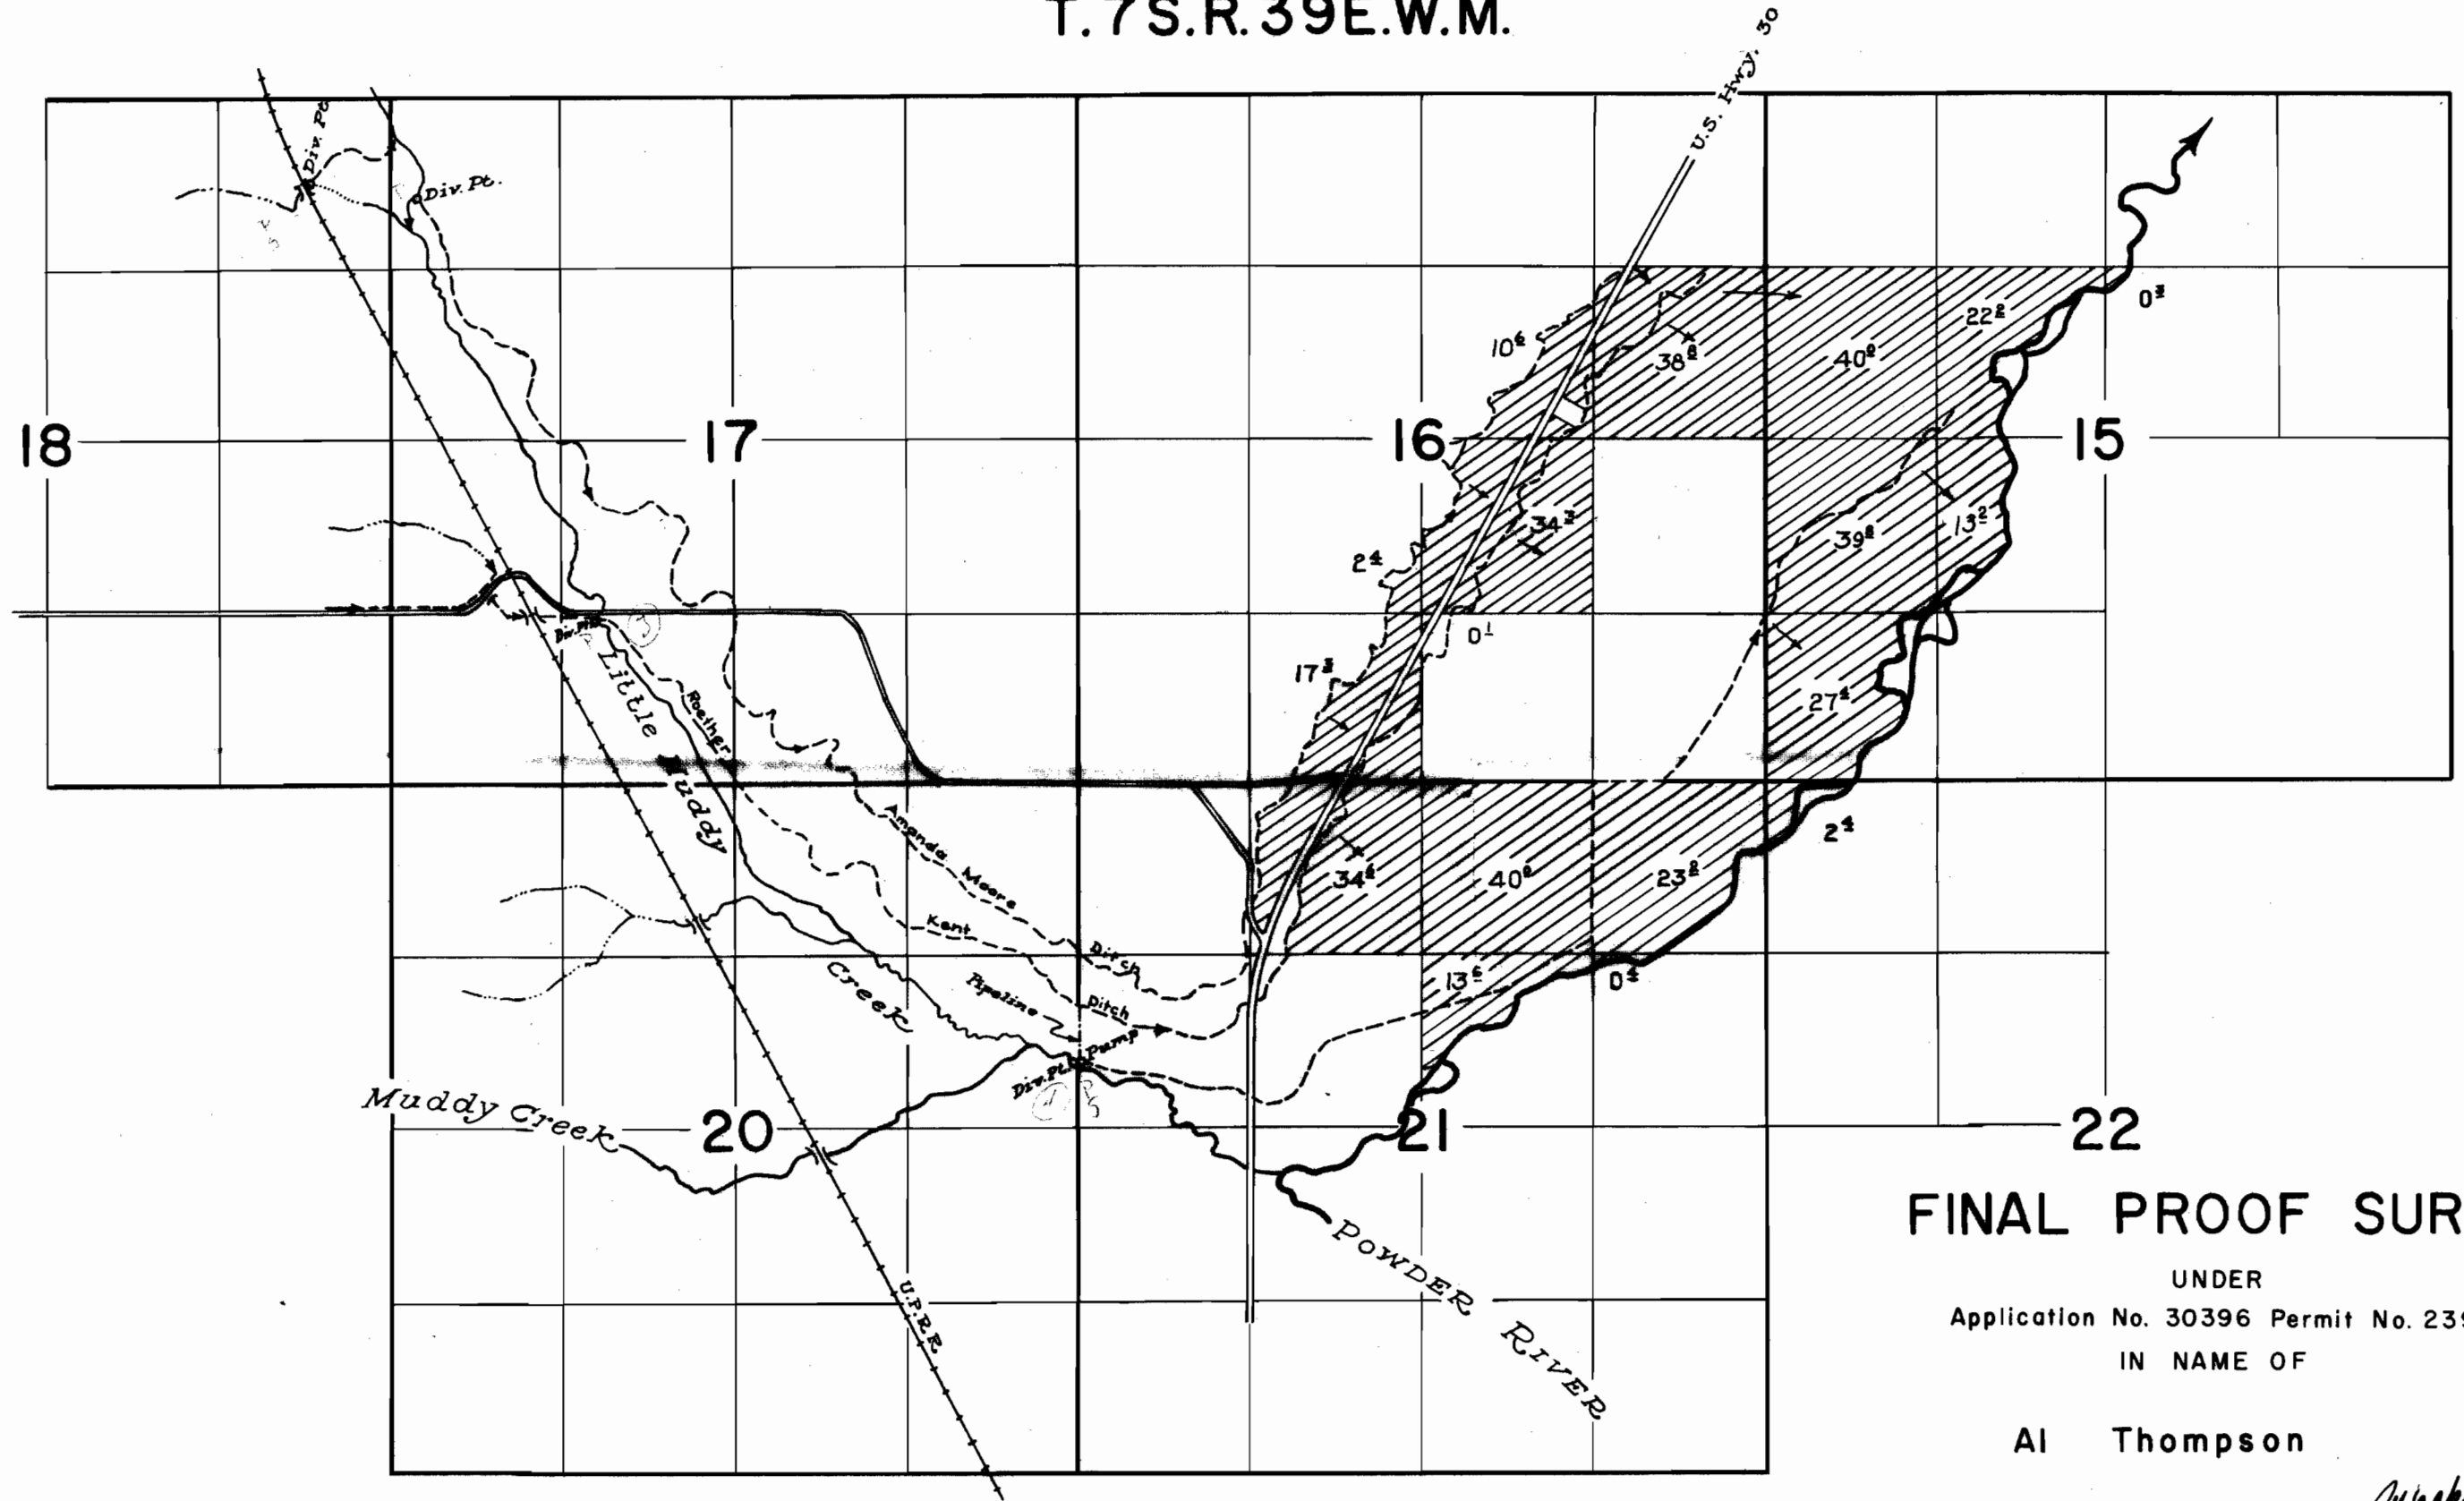

FINAL PROOF SURVEY

UNDER
Application No. 30396 Permit No. 23978
IN NAME OF

Al Thompson

Surveyed Sept. 19, 1960 by *Al Thompson*