


T.14S.R.5W.W.M.

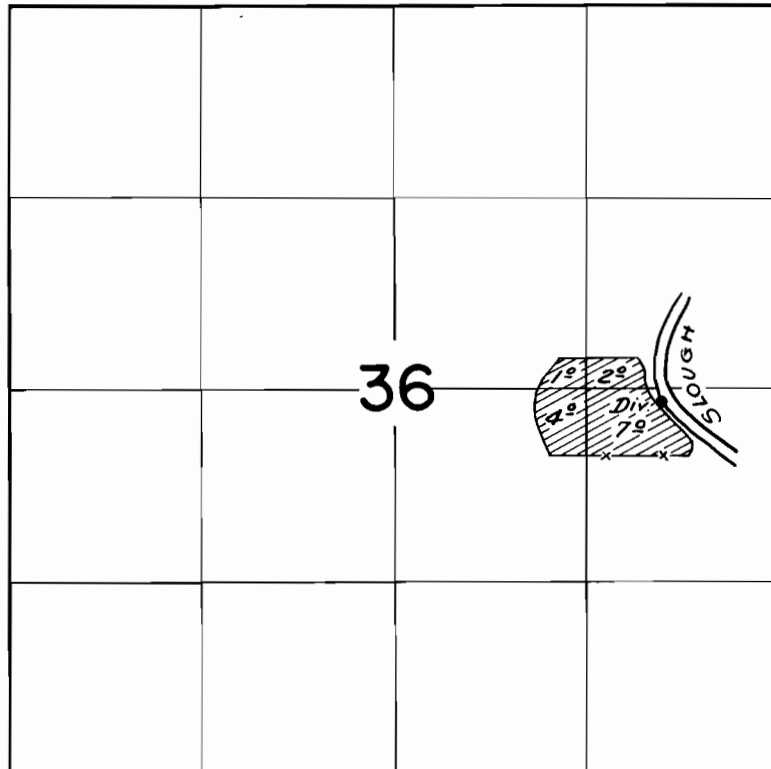

FINAL PROOF SURVEY
UNDER

Application No. 32492 Permit No. 25677...
IN NAME OF

MRS. ANNIE WALDEN

Surveyed Oct. 13, 1960, by *C.O. Butler*