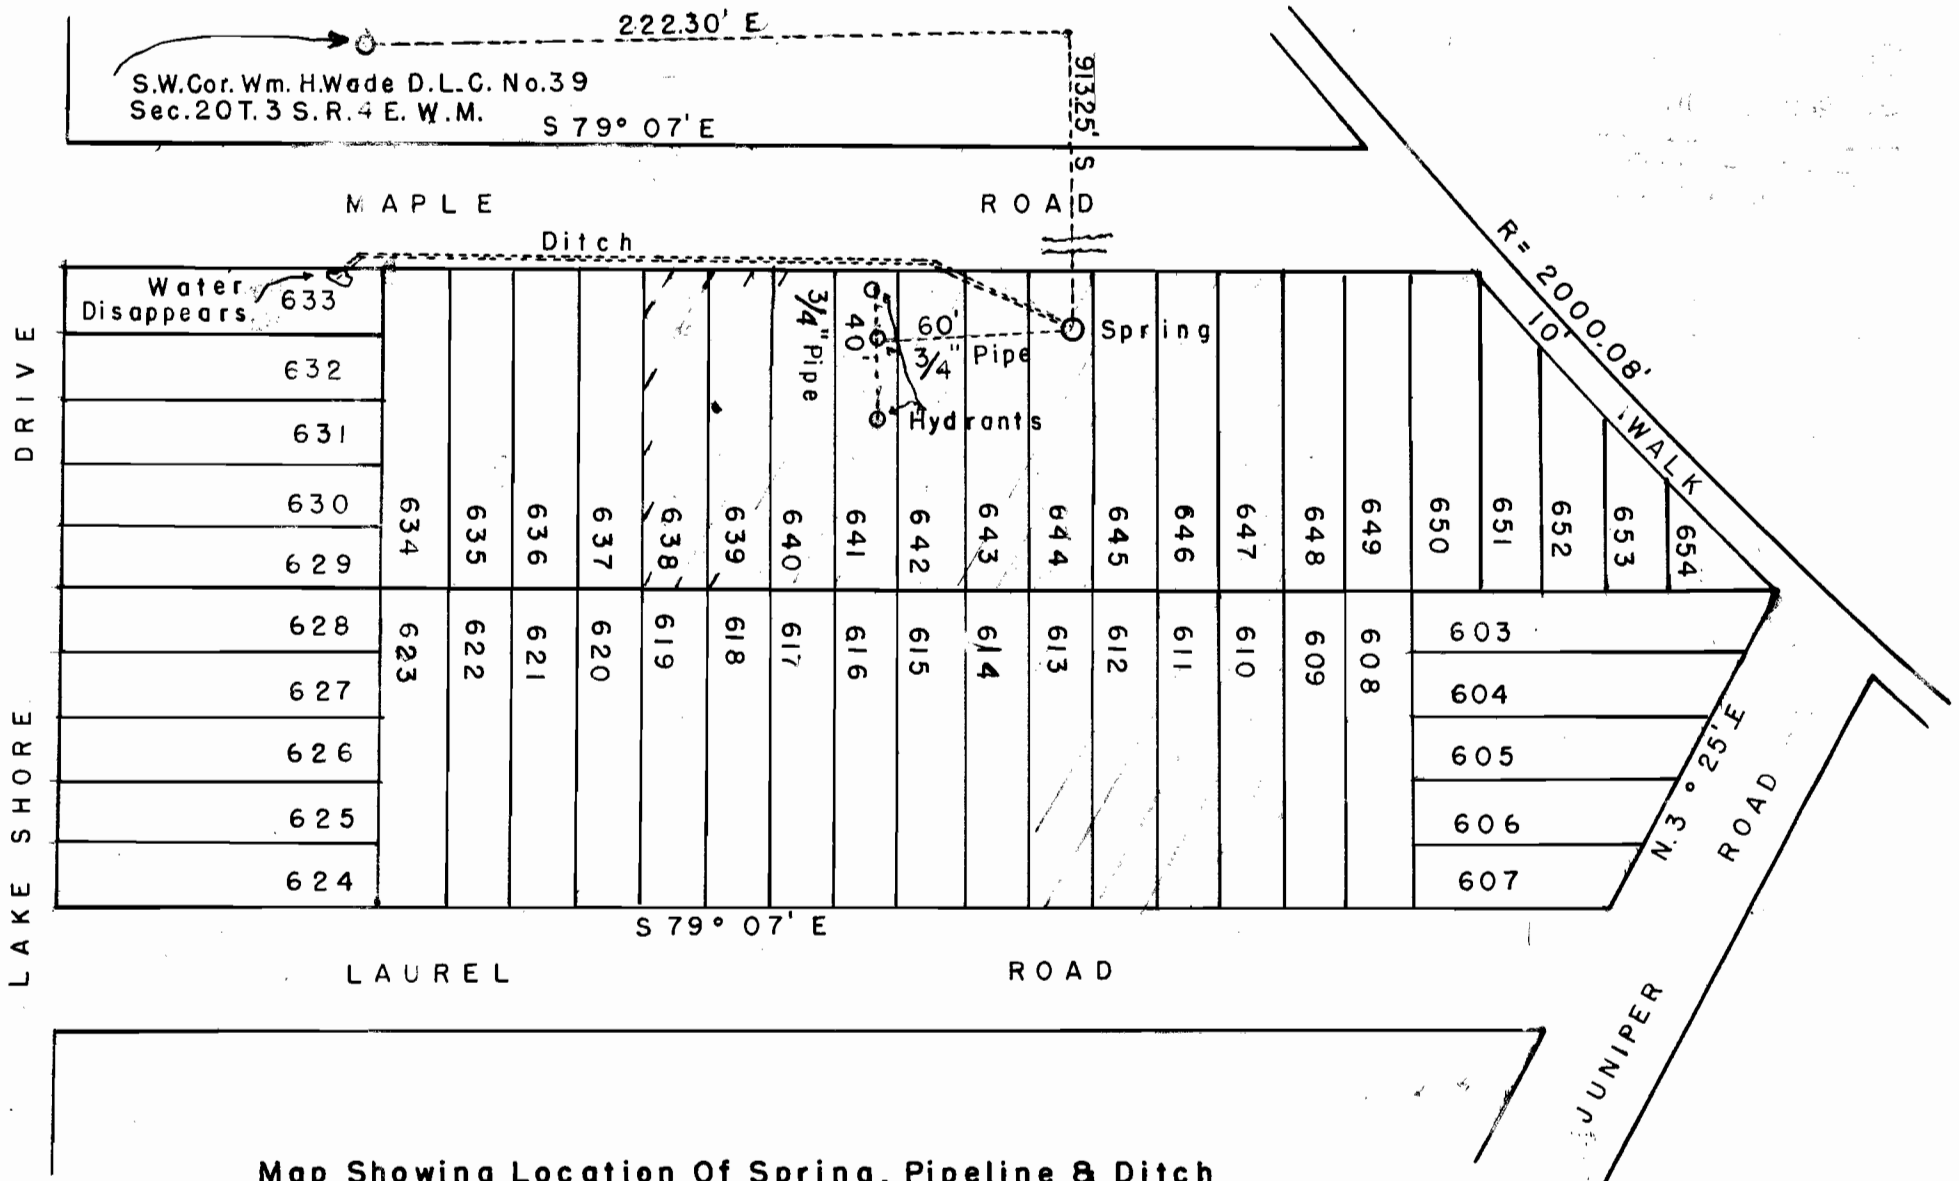



Map Showing Location Of Spring, Pipeline & Ditch
On Property Of A. J. Utt Estacada Oregon.
Drawn From Map Of ESTACADA LAKE, Clacamas
County Oregon. Twp. 3 South Range 4. East W. M.
Scale 1" = 60' SW¼ SE¼
½ Acre

Application No. 33413
Permit No. 26422

REGISTERED
OREGON
LAND SURVEYOR
Owen E Smith
OWEN E. SMITH
211