


T.30S.R.11W.W.M.

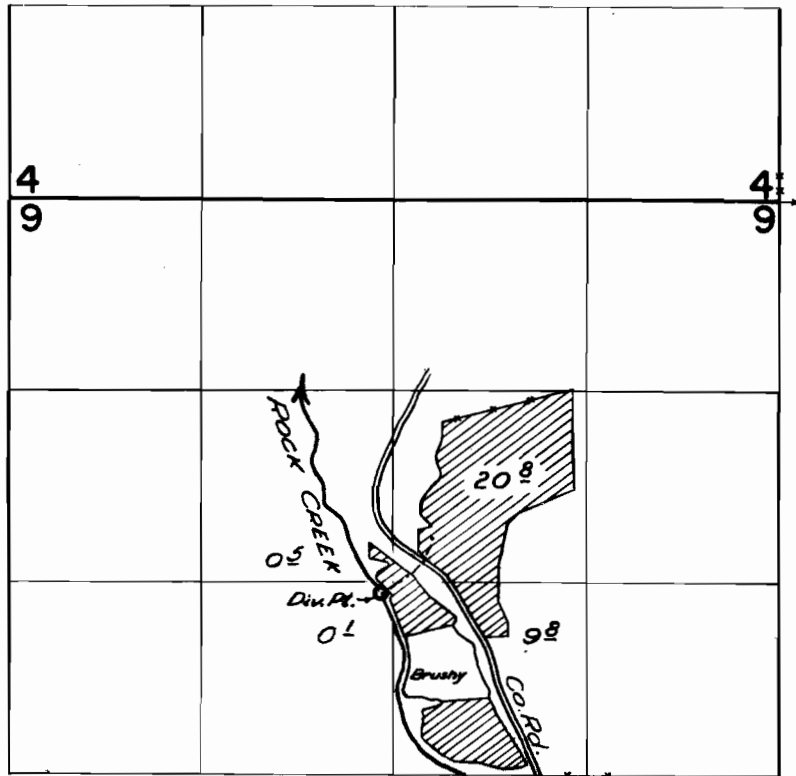

FINAL PROOF SURVEY UNDER

Application No. 29989 Permit No. 23622
IN NAME OF

Ernest F. Sell

Surveyed 9 JUNE 1960, by Tr. Bish