

POINT OF DIVERSION
 SET 1" I.P. 3' LONG
 WHICH IS 20.75' NORTH AND
 513.70' WEST OF SE CORNER
 NE 1/4 NE 1/4 SECTION 9
 TWP 26 SOUTH RANGE 13 W.W.M.

THIS POINT IS 27.2 FEET
 LOWER THAN HOUSE

110' VOLT 60 CYCLE ELECTRIC PUMP
 3450 RPM 1 1/2" MEYERS PUMP.
 RATED AT 800 G.P. HOUR

TO COAL BANK SLOUGH
 A TRIBUTARY OF COOS BAY

430'± OF 1" PIPE


20' ROADWAY

190'

68'

20'

1/16 CORNER

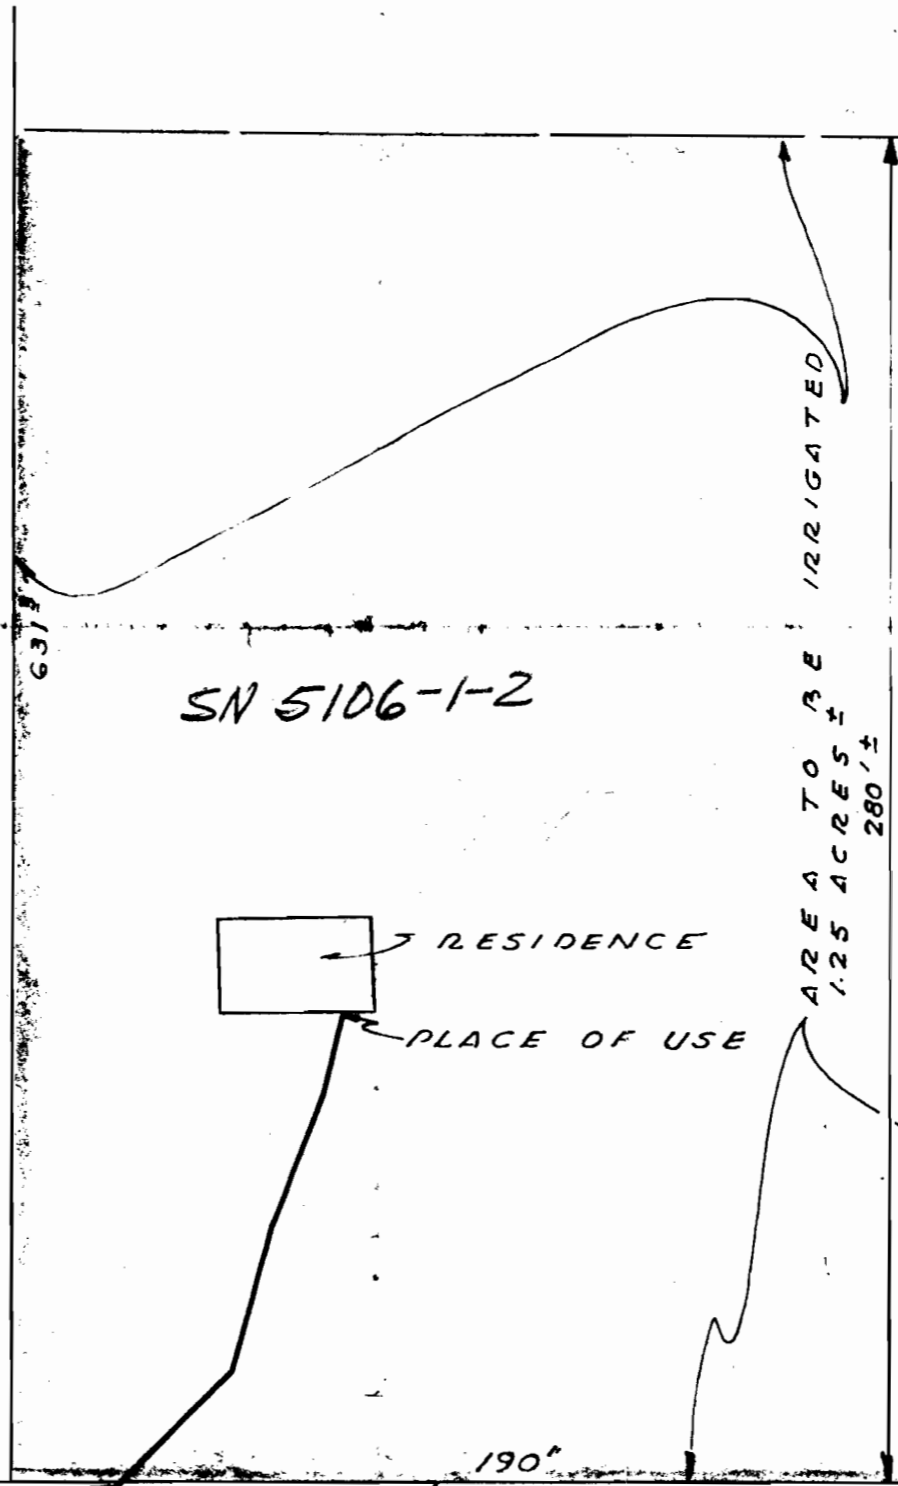

SECTION 9
 SECTION 10

SN 5106-1-2

RESIDENCE

PLACE OF USE

AREA TO BE IRRIGATED
 1.25 ACRES ±
 280 1/2

W/in Flanigan DLC 40
WATER RIGHTS SURVEY
 LOCATED IN NE 1/4, NE 1/4 OF SECTION 9
 TOWNSHIP 26 SOUTH RANGE 13 W.W.M.
 COOS COUNTY, OREGON
 SCALE: 1" = 40' SEPT. 10, 1956
 FOR BEN YEIK - BOX 236 - NORTH BEND, OREGON.

31137
 34601



RECEIVED
 JAN 24 1962
 STATE ENGINEER
 SALEM, OREGON