


# T.15S. R.16E.W.M.

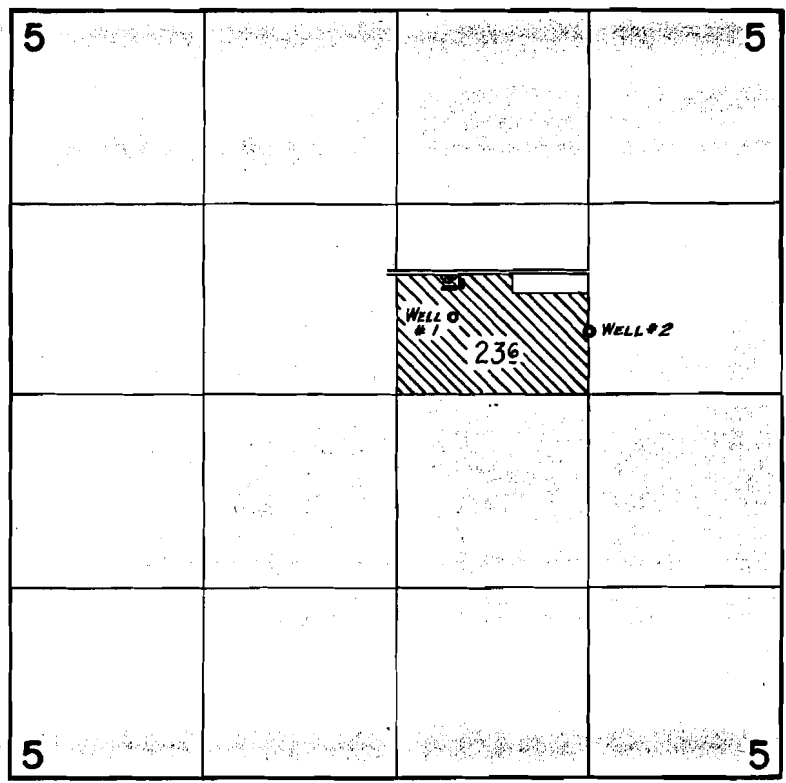

## FINAL PROOF SURVEY UNDER

Application No. G-86 Permit No. G-97  
IN NAME OF

Fred Hudspeth

Surveyed October 1, 1960, by [Signature]