


T.18 & 19 S. R.19 & 20 E. W.M.

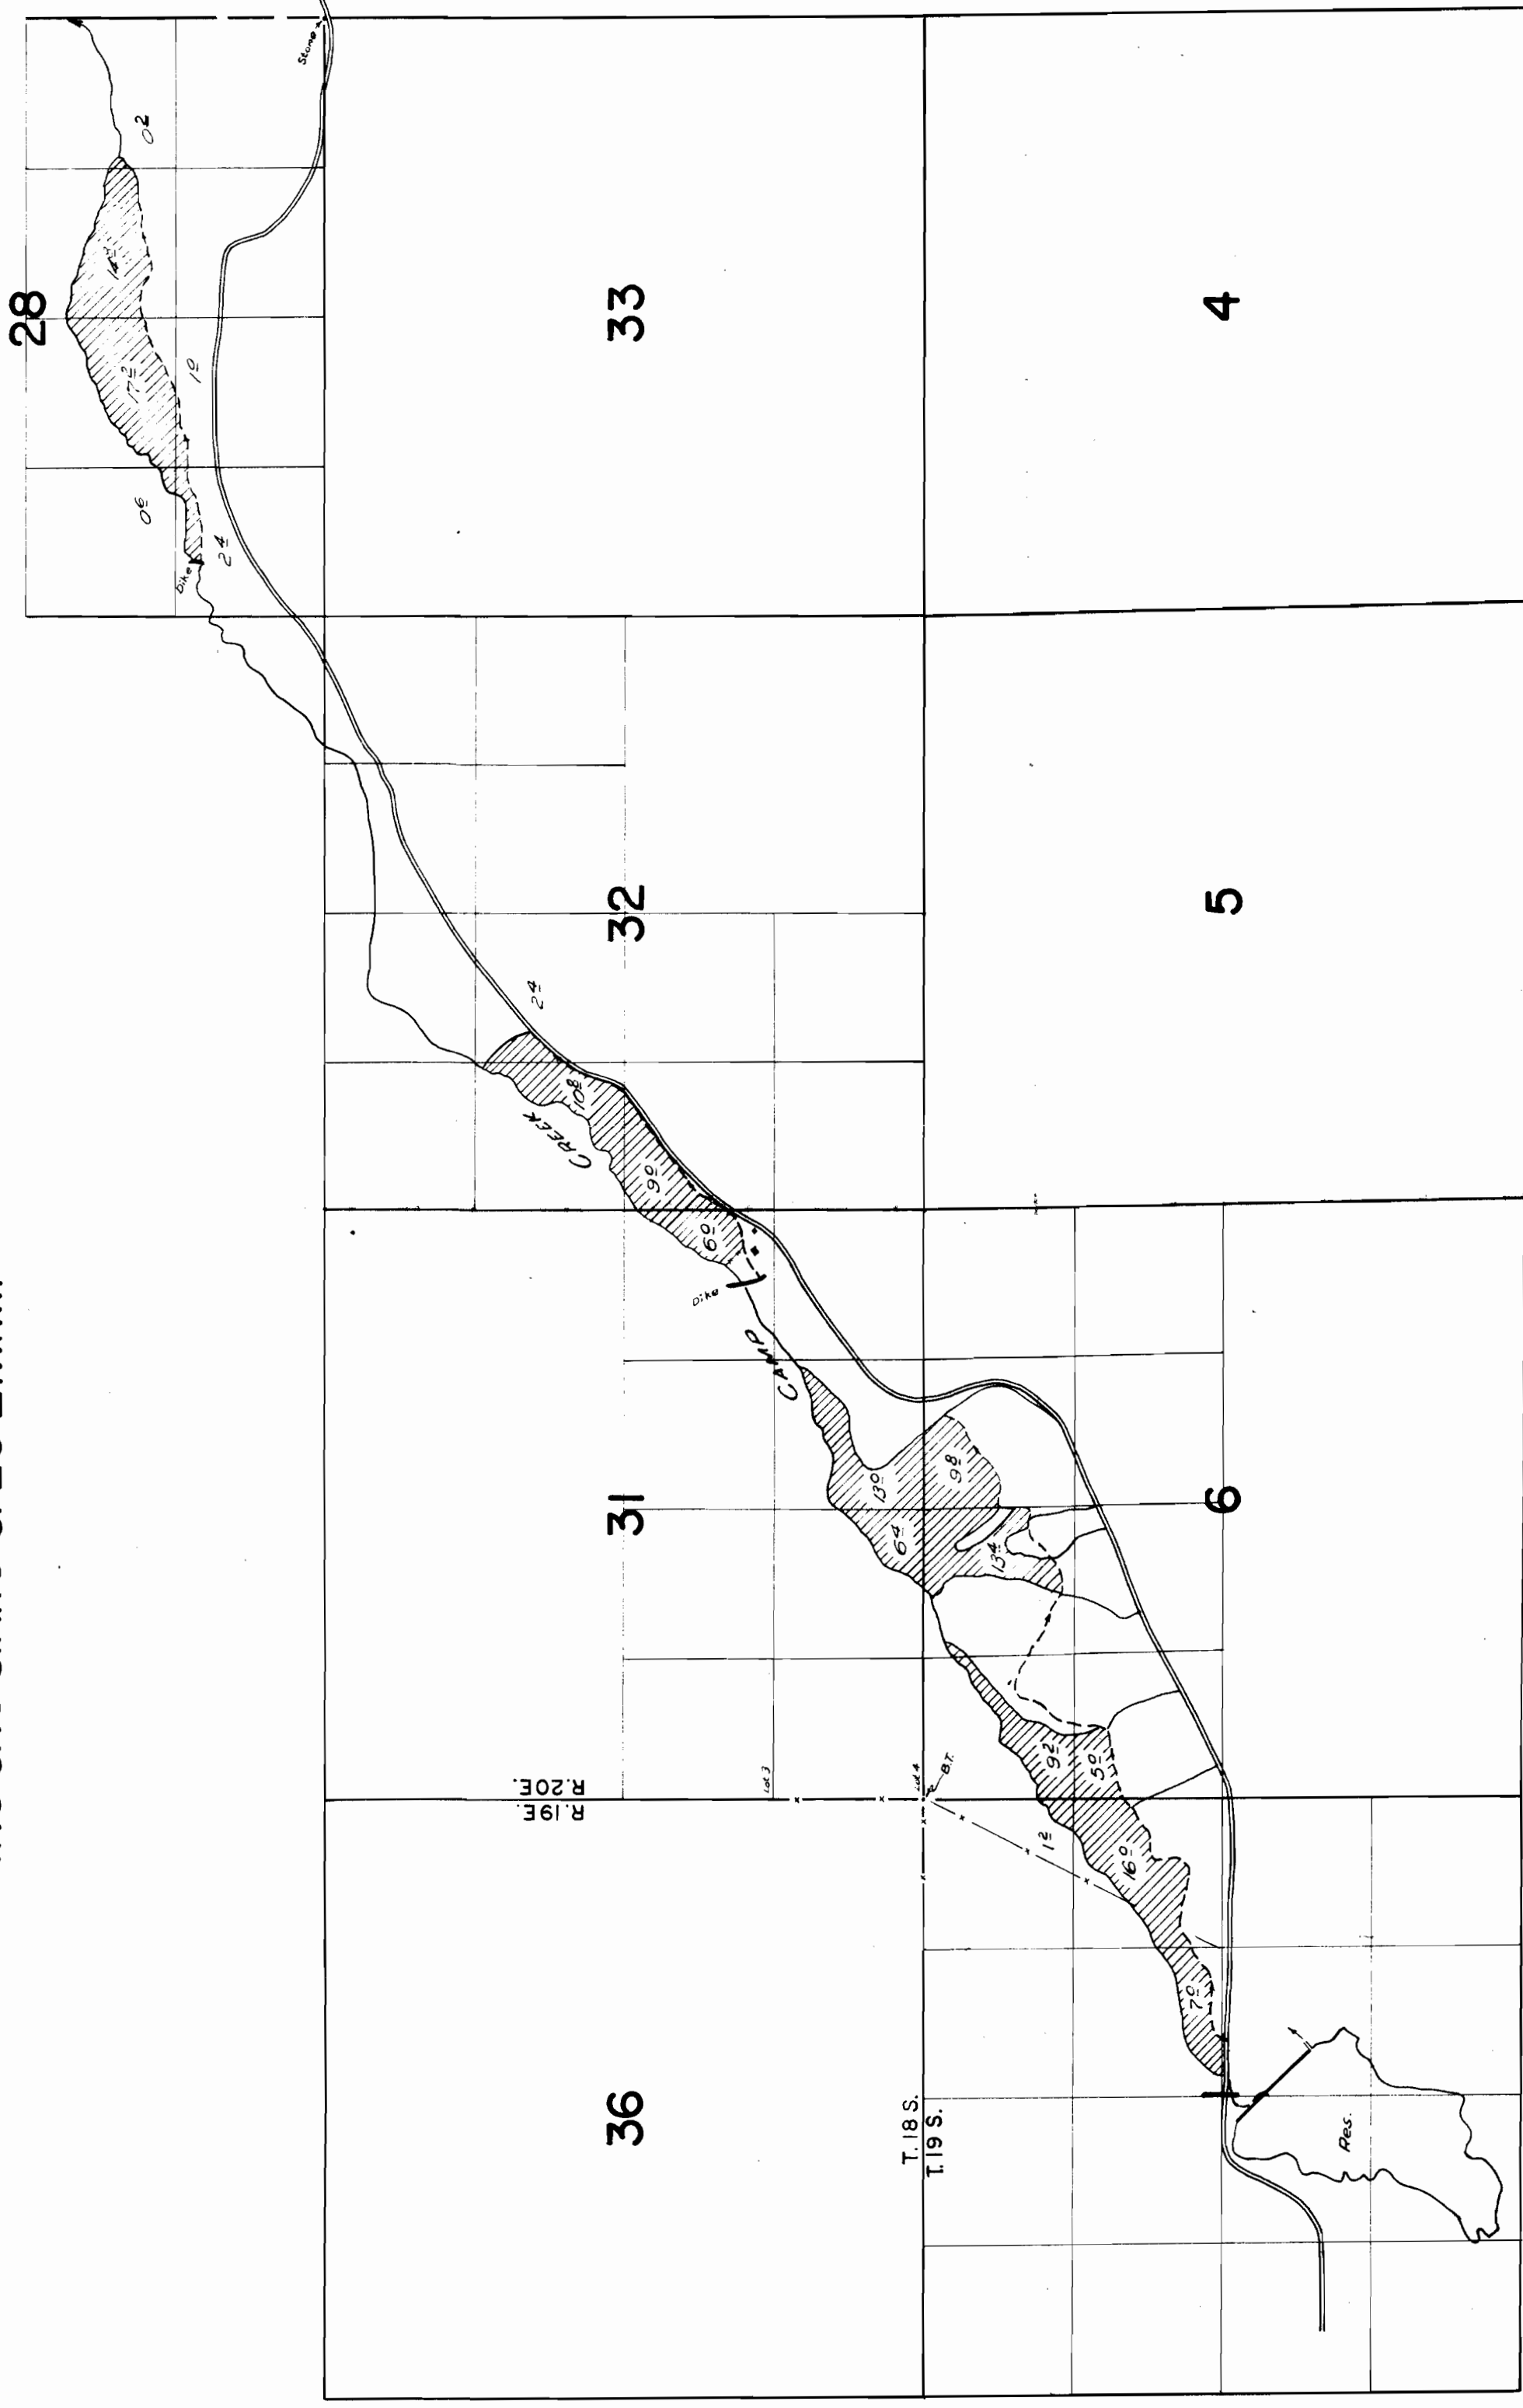

FINAL PROOF SURVEY

UNDER

R-20088 R-788

Application No. 20087 Permit No. 15724

IN NAME OF

THOMAS RICKMAN & SONS

Surveyed 30 Sept - 1 Oct 1960 by *Wm. B. Bish*

Do Not Take From File
Orig. from File
2-28-80
MSG FILED