


AMMENDED
 MAP TO ACCOMPANY APPLICATION
 FOR PERMIT
 TO
 APPROPRIATE WATER FOR IRRIGATION
 SHOWING
 CORRECTED LOCATION AND ACREAGE OF
 LAND TO BE IRRIGATED

SCALE: 1"=1320'

TOM RICHMAN : APPLICANT

RECEIVED
 AUG 30 1976
 WATER RESOURCES DEPT.
 SALEM, OREGON

LOCATION OF KLUGHMAN CREEK
 DAM BASED ON ORIGINAL MAP
 TO ACCOMPANY APPLICATION AS
 PREPARED AND CERTIFIED BY
 PAUL R. REVIS OF BURNS, ORE.

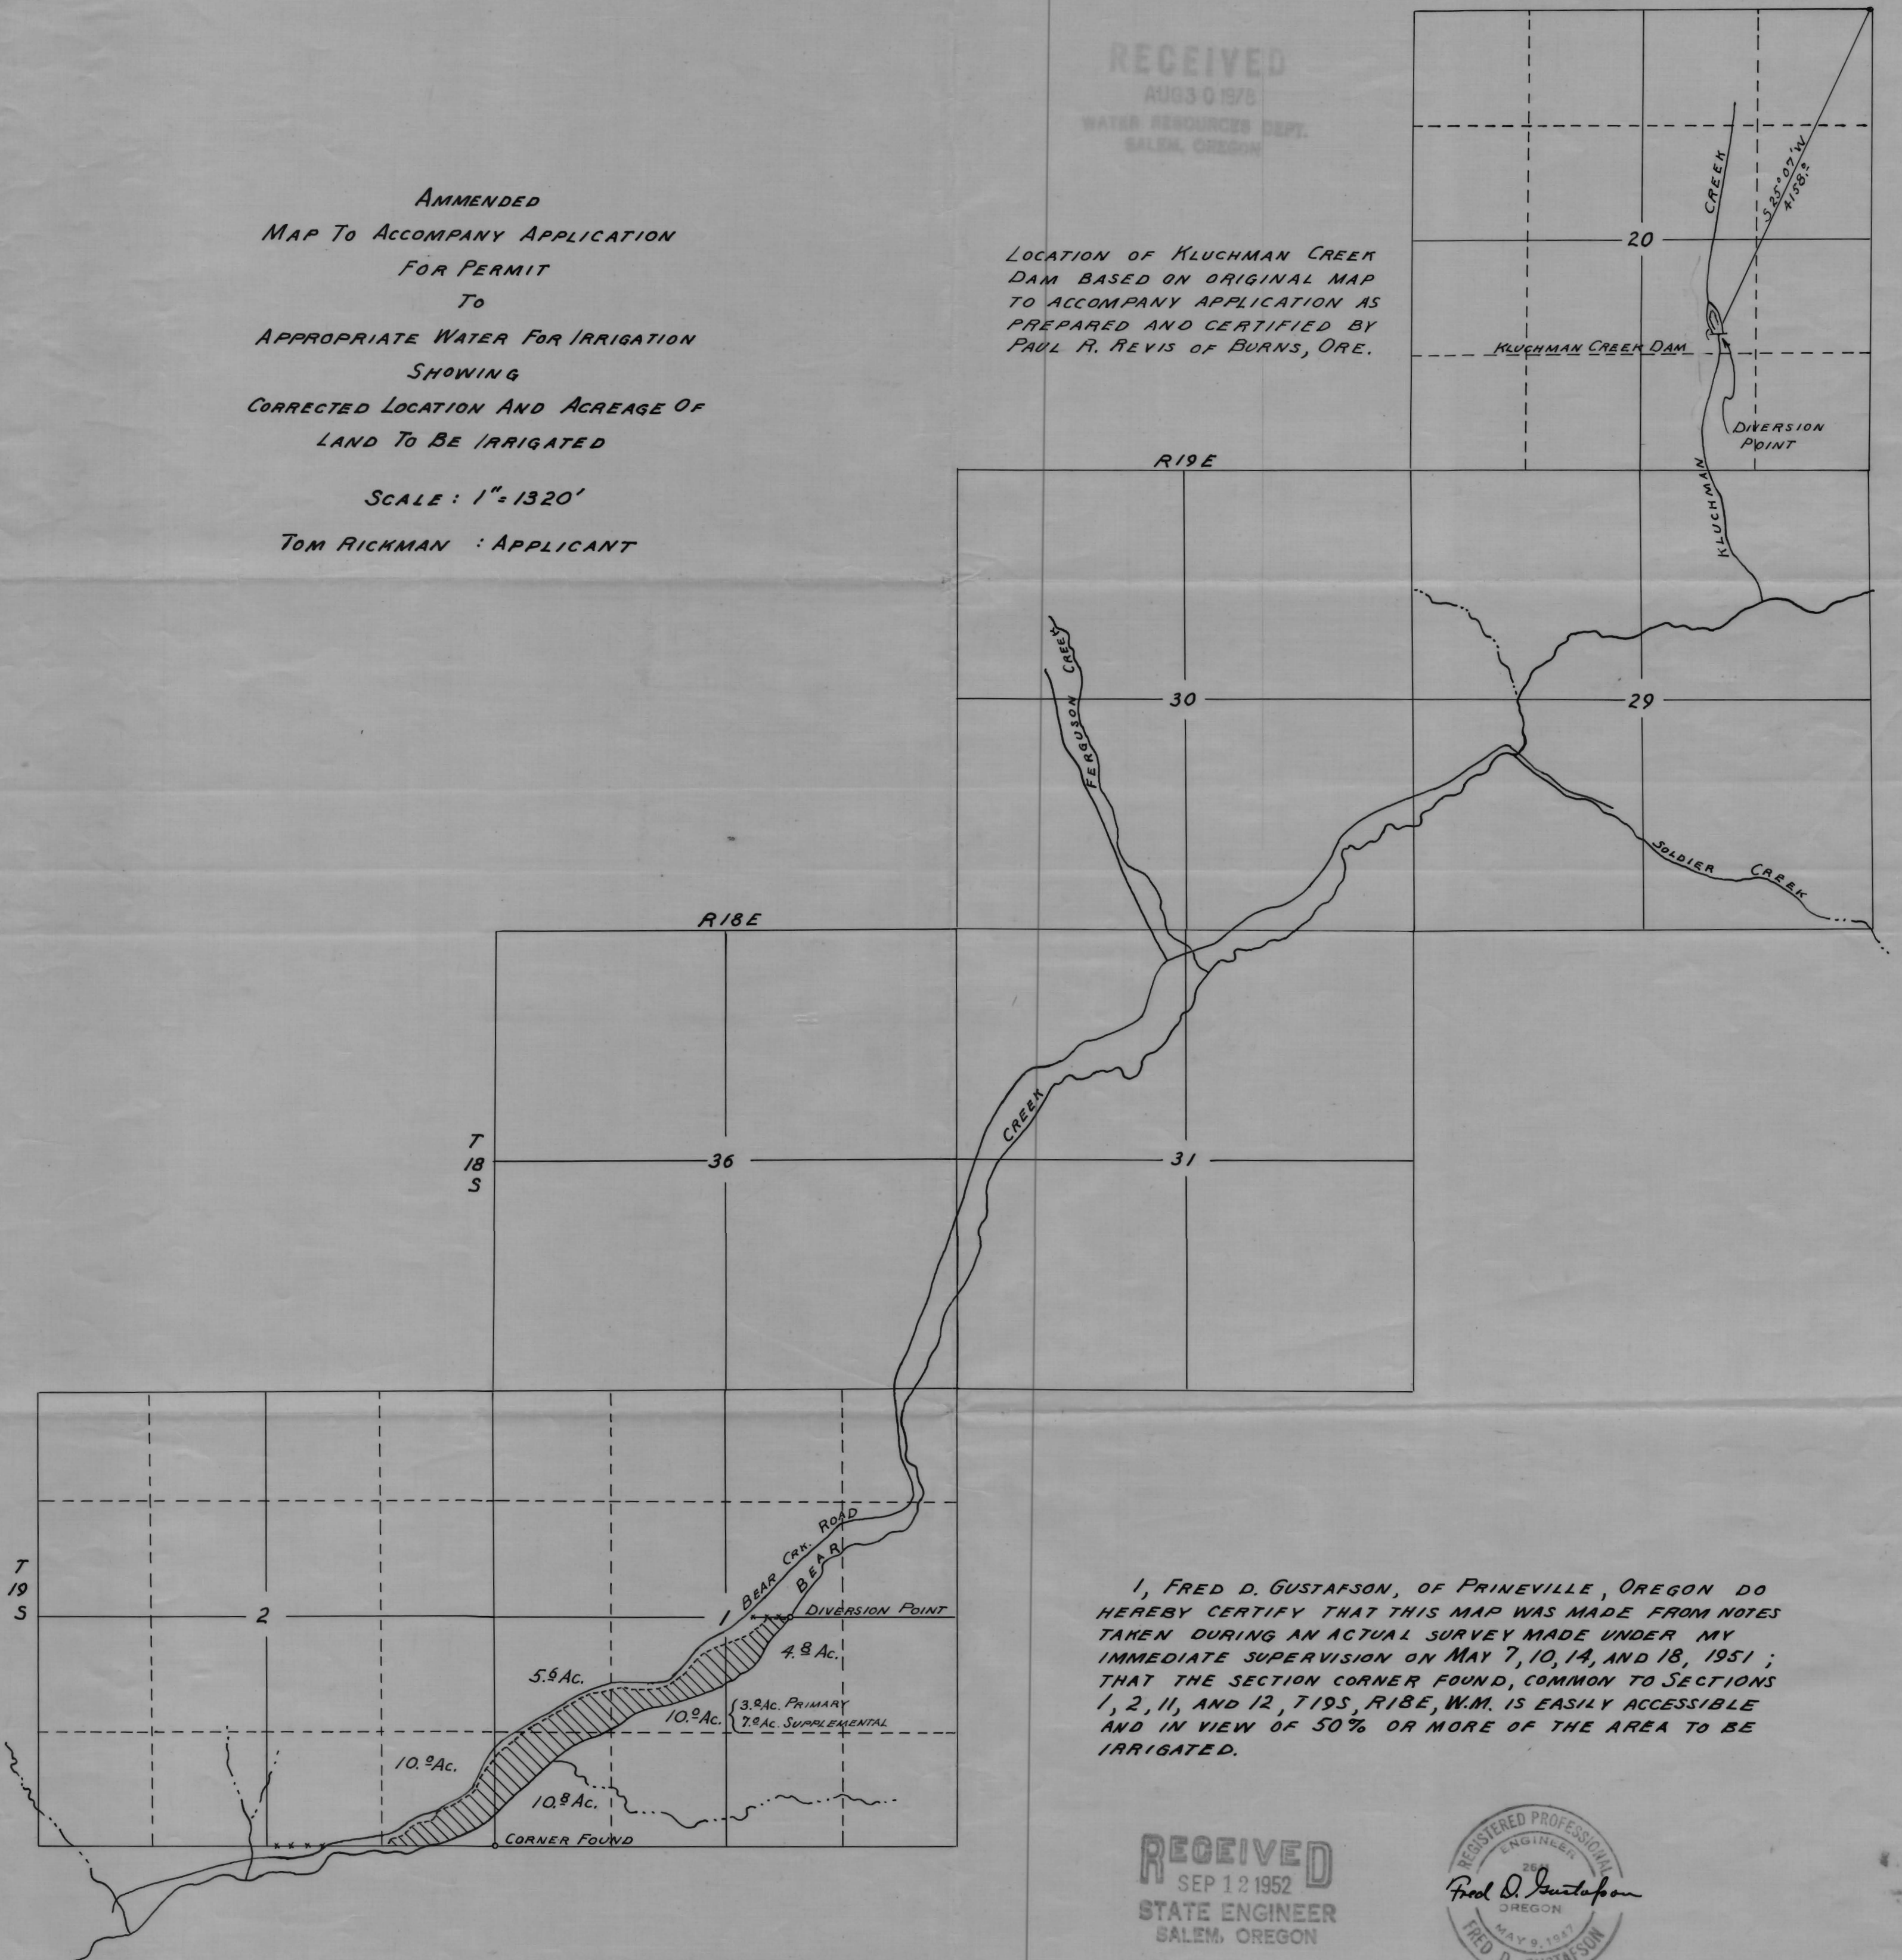

I, FRED D. GUSTAFSON, OF PRINEVILLE, OREGON DO
 HEREBY CERTIFY THAT THIS MAP WAS MADE FROM NOTES
 TAKEN DURING AN ACTUAL SURVEY MADE UNDER MY
 IMMEDIATE SUPERVISION ON MAY 7, 10, 14, AND 18, 1951 ;
 THAT THE SECTION CORNER FOUND, COMMON TO SECTIONS
 1, 2, 11, AND 12, T19S, R18E, W.M. IS EASILY ACCESSIBLE
 AND IN VIEW OF 50% OR MORE OF THE AREA TO BE
 IRRIGATED.

RECEIVED
 SEP 12 1952
 STATE ENGINEER
 SALEM, OREGON



Application No. R-24231
 Permit No. 27637
 R-1378
 21569