


T.13S., R.16E., W.M.

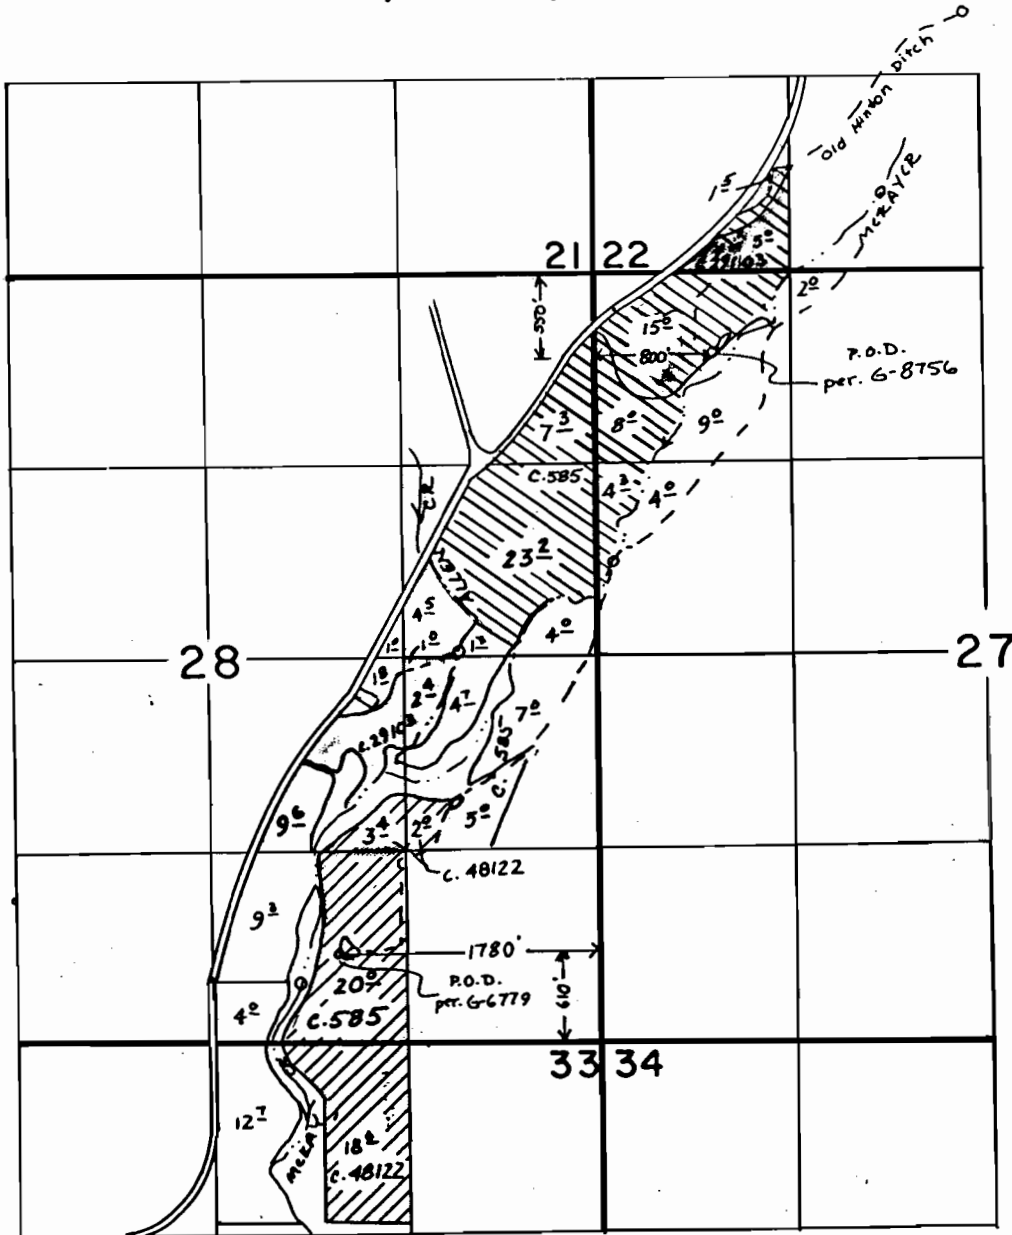

SCALE : 1" = 1320'

5-29733

FINAL PROOF SURVEY

UNDER

Application No. G-9322 Permit No. G-8756
G-7350 Permit No. G-6779
 IN NAME OF



J. DOUG DUNN

Surveyed OCT. 16 1986, by L. OLSON