
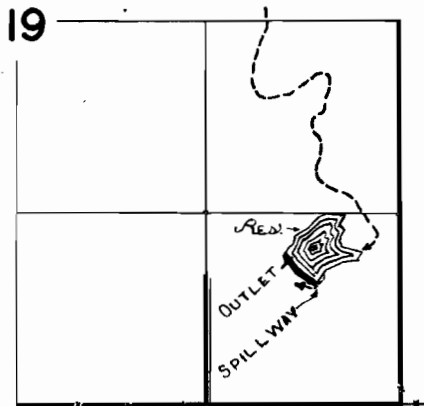


T.16S. R.19E. W. M.

T.16S. R.19E. W. M.

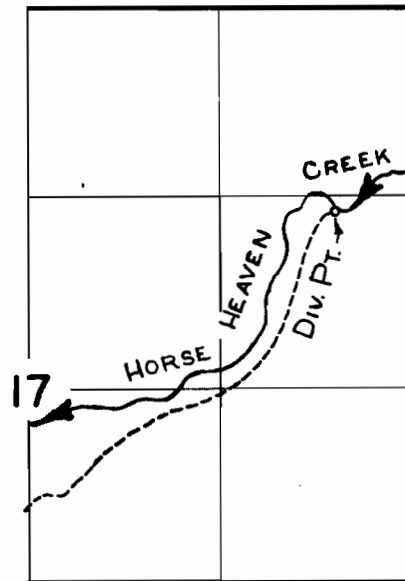

FINAL PROOF SURVEY
UNDER

Application No. R-31833 31848 Permit No. R-2062 25062
IN NAME OF

JOE SHOUN

Surveyed SEPT. 27 1960, by M. BISH

1960-C
DCY-11H 201
DCY-11H 156