
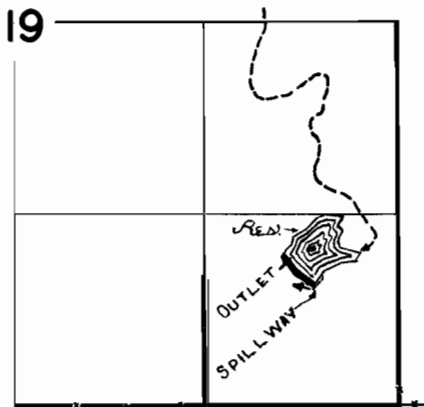


T.16S. R.19E. W. M.

T.16S. R.19E. W. M.

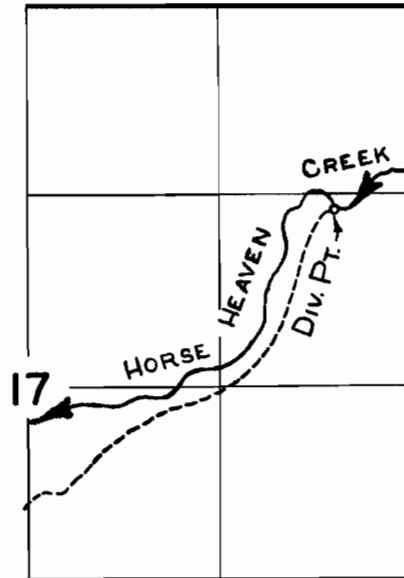

FINAL PROOF SURVEY
UNDER

Application No. ^{R-31833} 31848 Permit No. ^{R-2062} 25062
IN NAME OF

..... JOE SHOUN

Surveyed SEPT. 27, 1960. by M. BISH

1960-C
DCY-11H 201
DCY-11H 156

RF