


T.23S.R.31E.W.M.

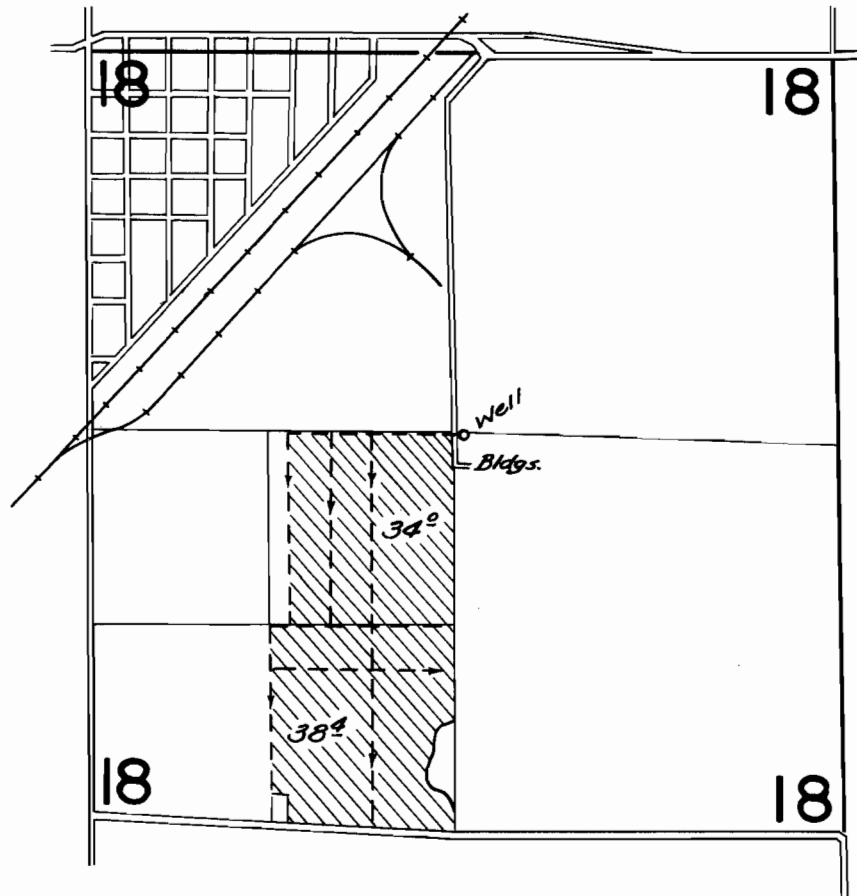

FINAL PROOF SURVEY
UNDER

Application No. *G-197*... Permit No. *G-109*...
IN NAME OF

J. C. & LOTTA J. CLEMENS

Surveyed *Oct. 22* 1960, by *C. O. Barrett*