


T.23S.R.32E.W.M.

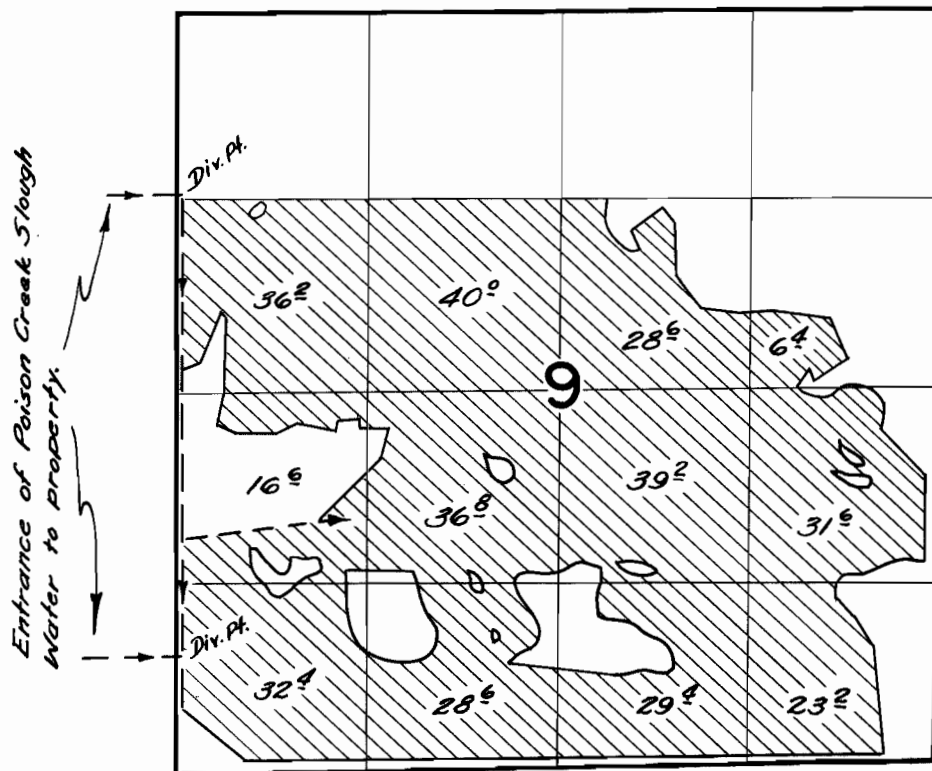

FINAL PROOF SURVEY
UNDER

Application No. 29276 Permit No. 23122
IN NAME OF

J. C. & Lotta J. Clemens

Surveyed July 23, 1958, by N. N. Perry