


T. 39S. R. 5W. W.M.

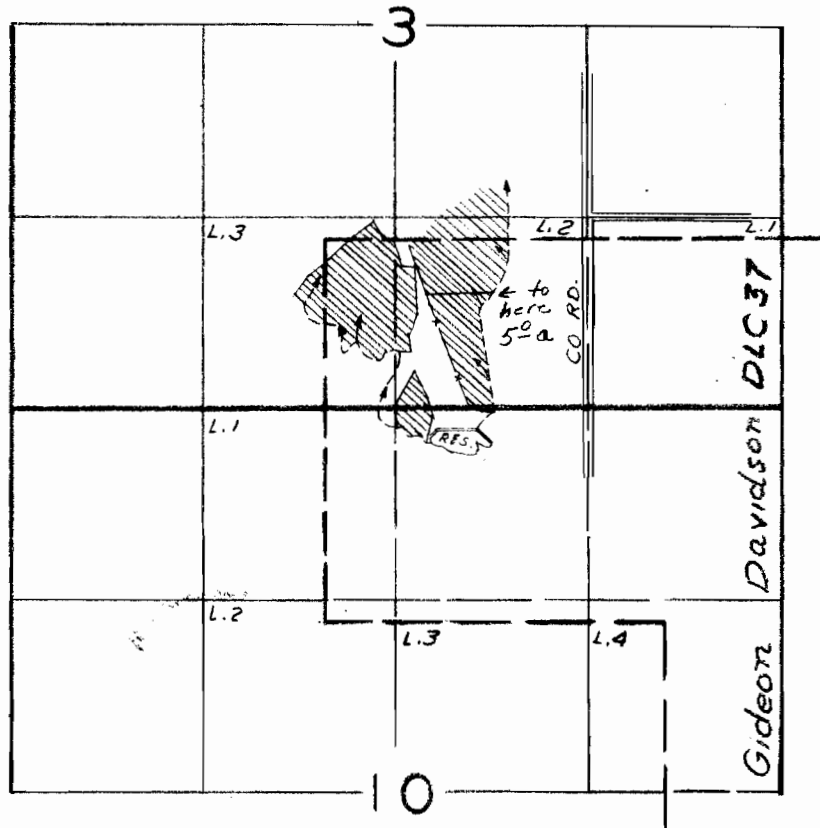

Tracing of survey made on Virgil Berry
farm on April 14, 1961 by R.D. Steimer

R.D. Steimer