


T.19S. R.2W.W.M.

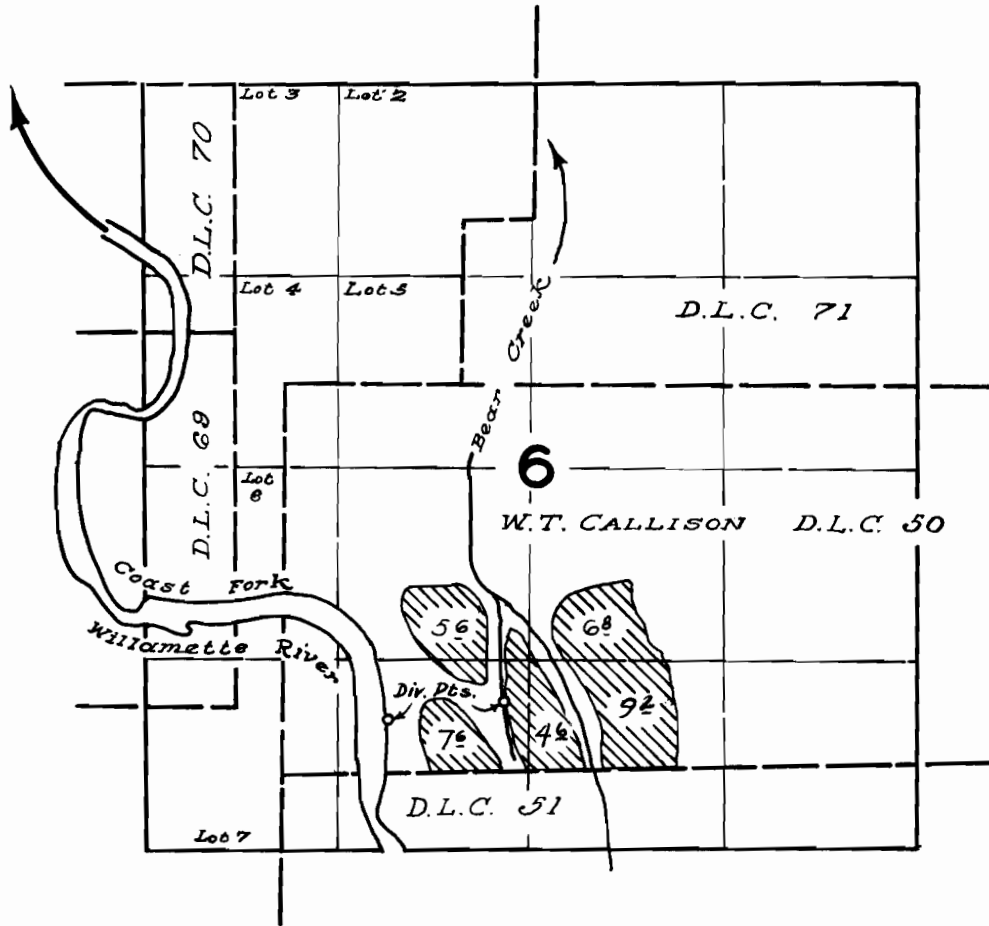

**FINAL PROOF SURVEY**  
UNDER

Application No. 30165... Permit No. 23567.  
IN NAME OF

**EDWARD E. SIMONS**

Surveyed May 13 1960, by *R. Jackson*