


T.18 & 19 S. R.1 W.W.M.

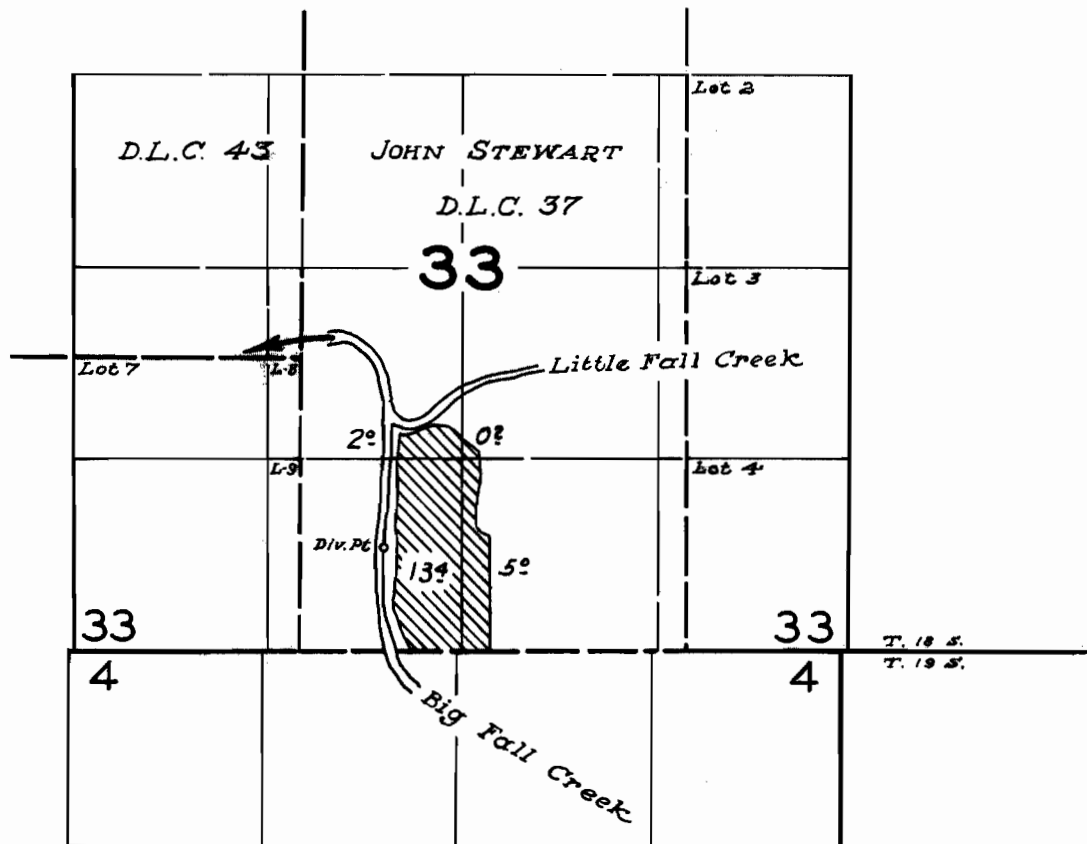

FINAL PROOF SURVEY
UNDER

Application No. 33276.. Permit No. 26304..
IN NAME OF

HOWARD H. HENRY

Surveyed May 5, 1960, by D. Jackson