


2
2
4
7

Sec. 9, Twp. 8 S. Range 2 E. W. M.

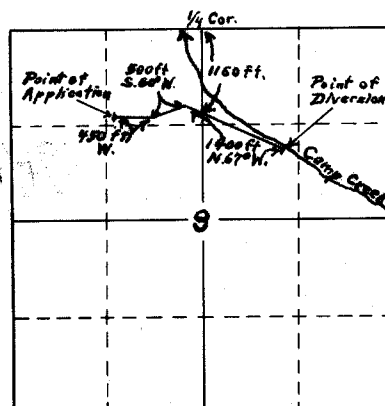

Note:
Dam less than 5 feet in height.
Less than 3 second feet applied for.

Scale: 2 ins = 1 Mile.

SILVER FALLS TIMBER CO.

2
0
4
7

Application No. 7299
Permit No. 4611