


Per. 23444
29149

T. 5 S., R. 33 E. W. M.

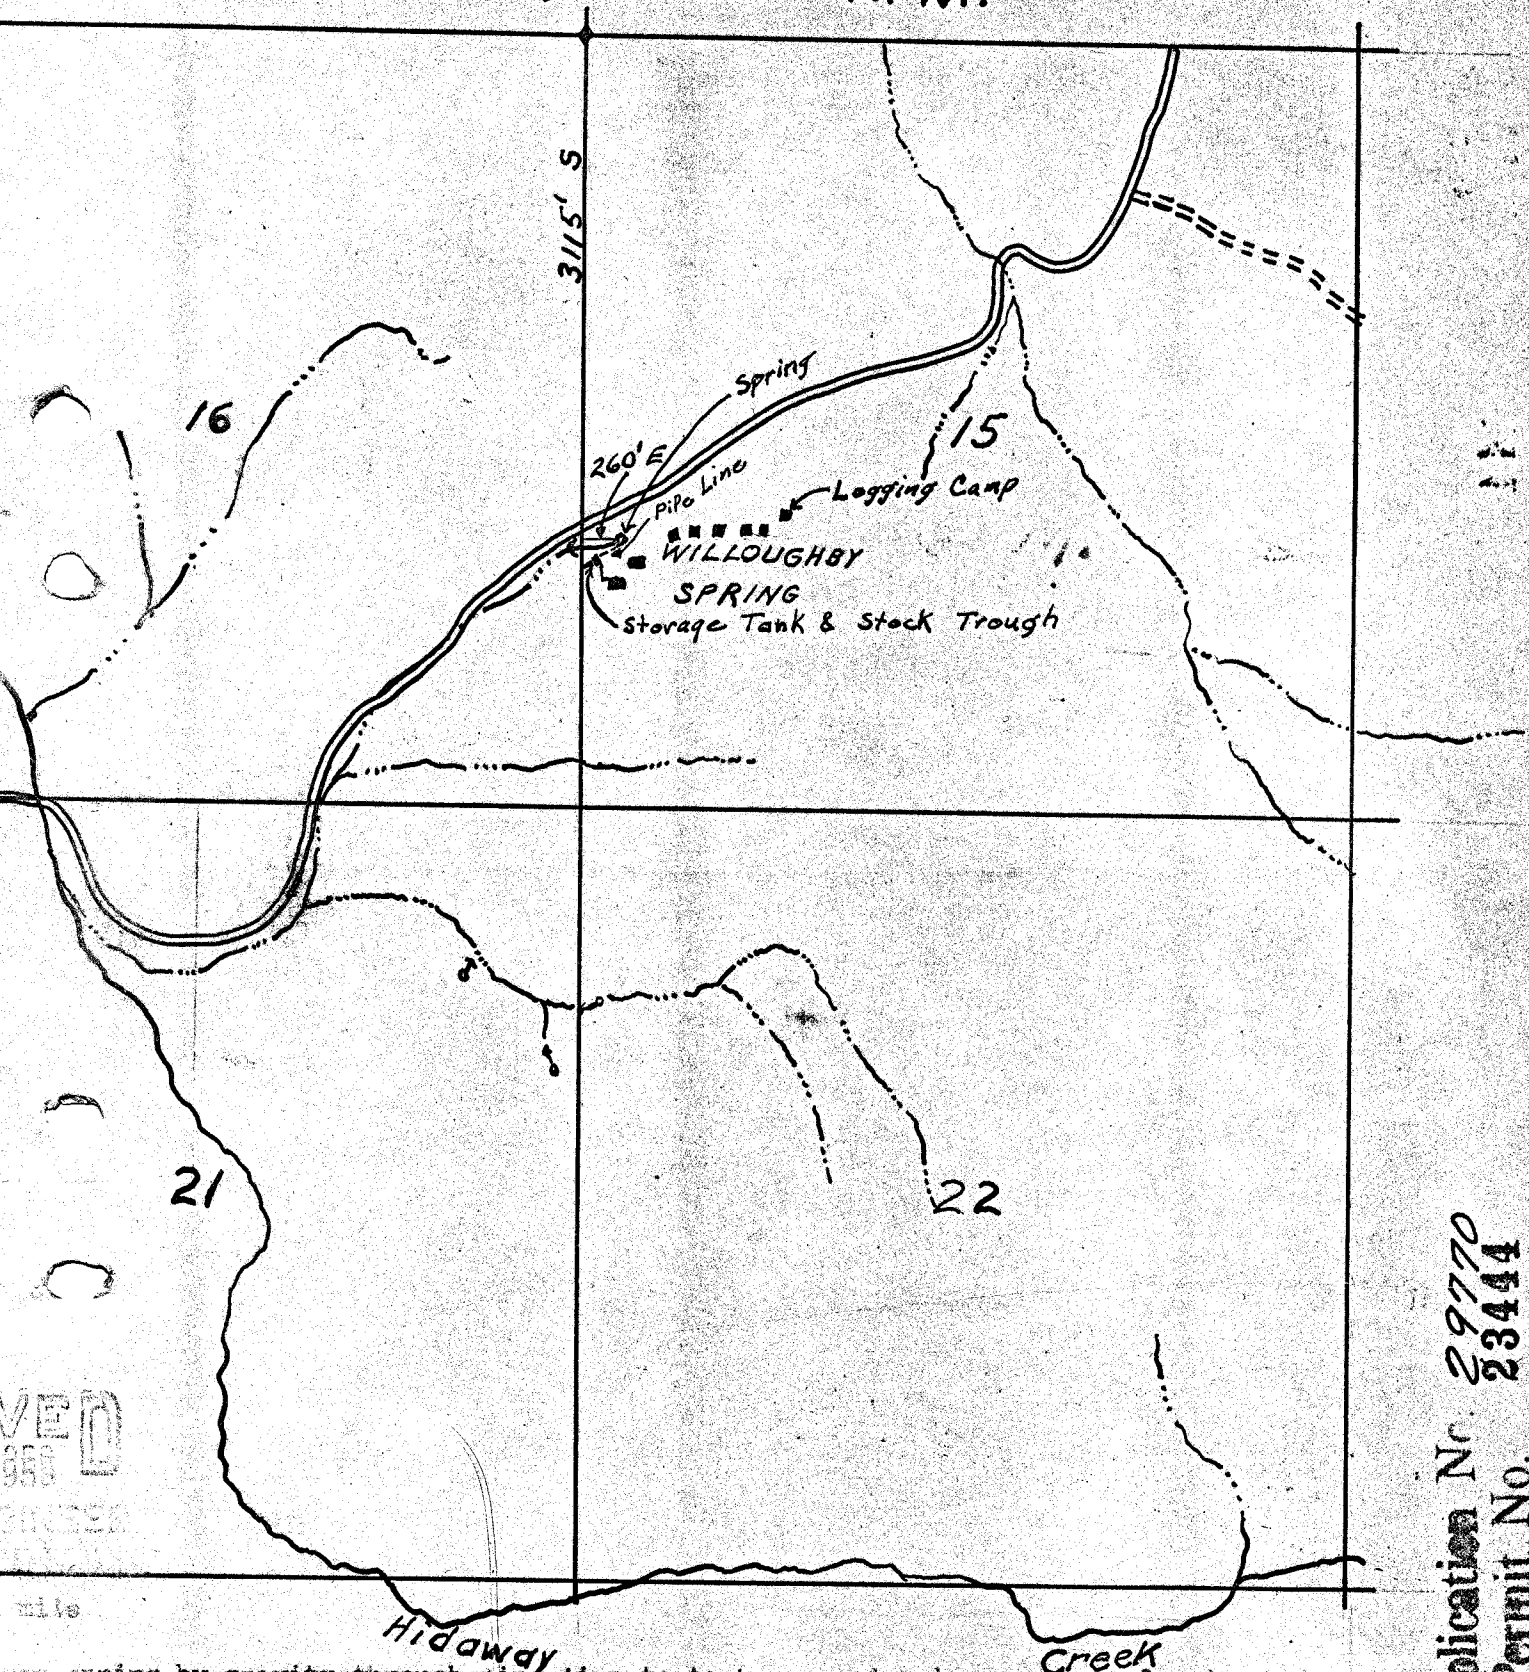

VED
955

From spring by gravity through pipe line to tank, pumped under pressure for domestic use, surplus from tank by gravity to stock trough for use of range stock. Both in section 15, T. 5 S., R. 33 E. W. M. Reference monument set at spring, 3115 feet 60 feet East of NW section corner of section 15.

Application No. 29770
Permit No. 23444

29770