


PLAT SHOWING LAND IRRIGATED BY C.J. JENNINGS,

Scale 4" to 1 mile.

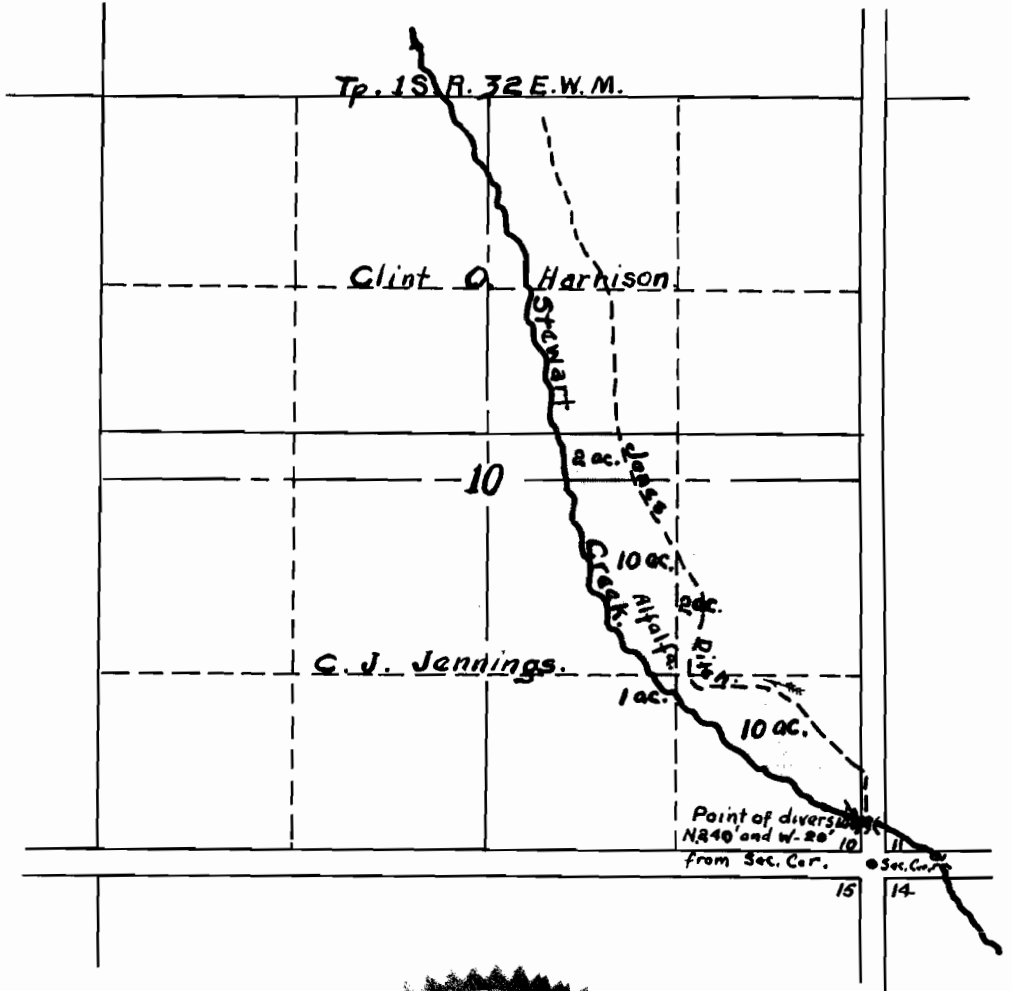

MAY 3 1920



Section No. 7255
Plat No. 4646