


N/4 Corner of Section 12.

Per 24656  
29150

U.S. F.S. Road  
To Frazier Rd.  
N.E. 1/4 Sec. 12  
Found.  
B.T. Found.

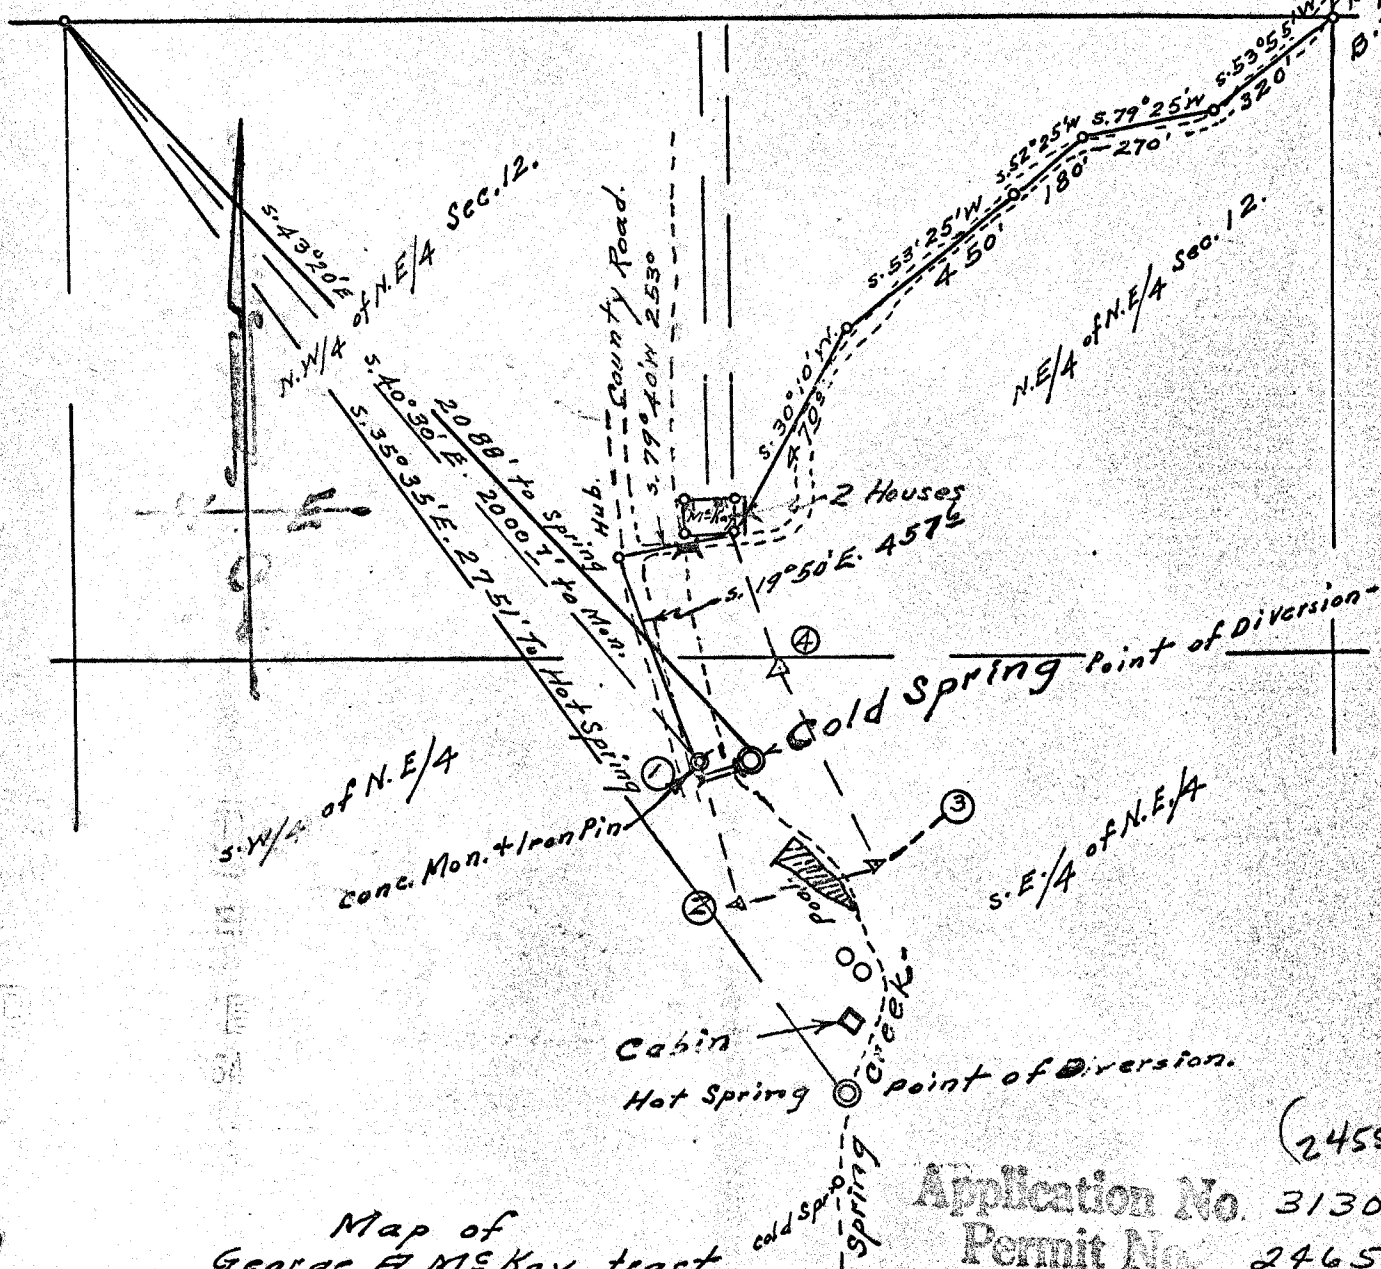

Map of  
George F. McKay tract  
Located in N/2 of N.E. 1/4 Sec. 12  
Twp. 5S, Range 33 E. W. M.  
Surveyed, staked & plotted Nov. 1952 - & checked Sept 1954  
By W. E. O. Criger. — Scale: 1" = 400'

Application No. 31306  
Permit No. 24656  
20192



I, W. E. O. Criger of Pendleton, Oregon do hereby certify  
that this map was made from notes taken during  
an actual survey made by me on Sept. 23, 1954;  
that the monuments on this map, shown at  
location of springs consist of iron pipes 3 ft. long  
with the top left 6" above the ground; as follows:  
S. 43° 20' E. 2088 Ft. to Spring. and  
S. 35° 35' E. 2751 Ft. to Spring.

4