


T. 4 S. R. 39 E. W.M.

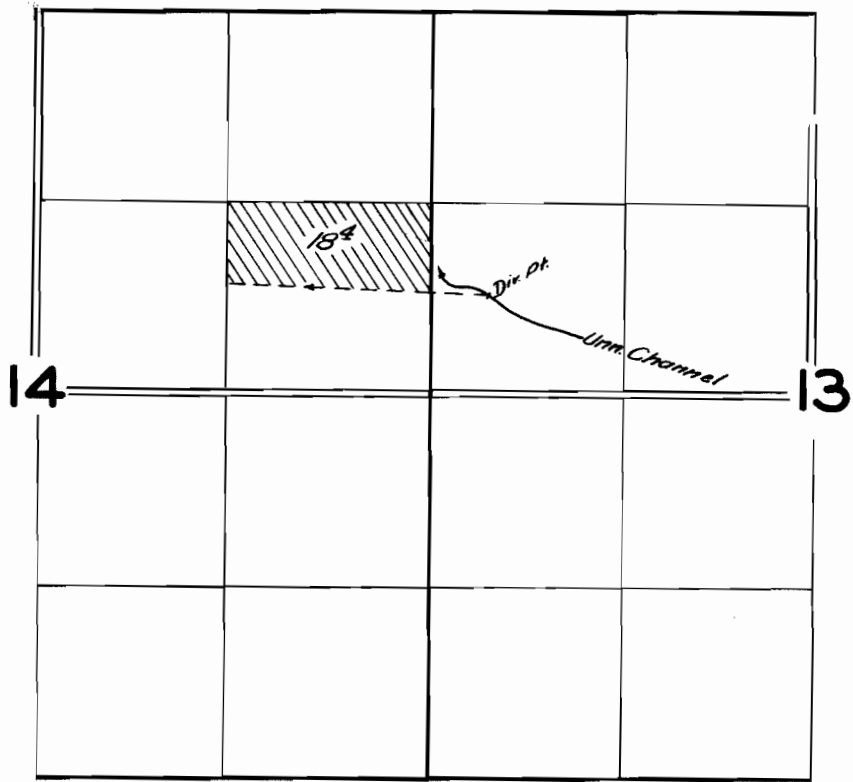

**FINAL PROOF SURVEY**  
UNDER

Application No. *22931*... Permit No. *18076*...  
IN NAME OF

.....*James Conoway*.....

Surveyed *Aug. 8*... 19*59*, by *C.O. Buelcke*.....