


TOWNSHIP 10 S., RANGE 6 E.

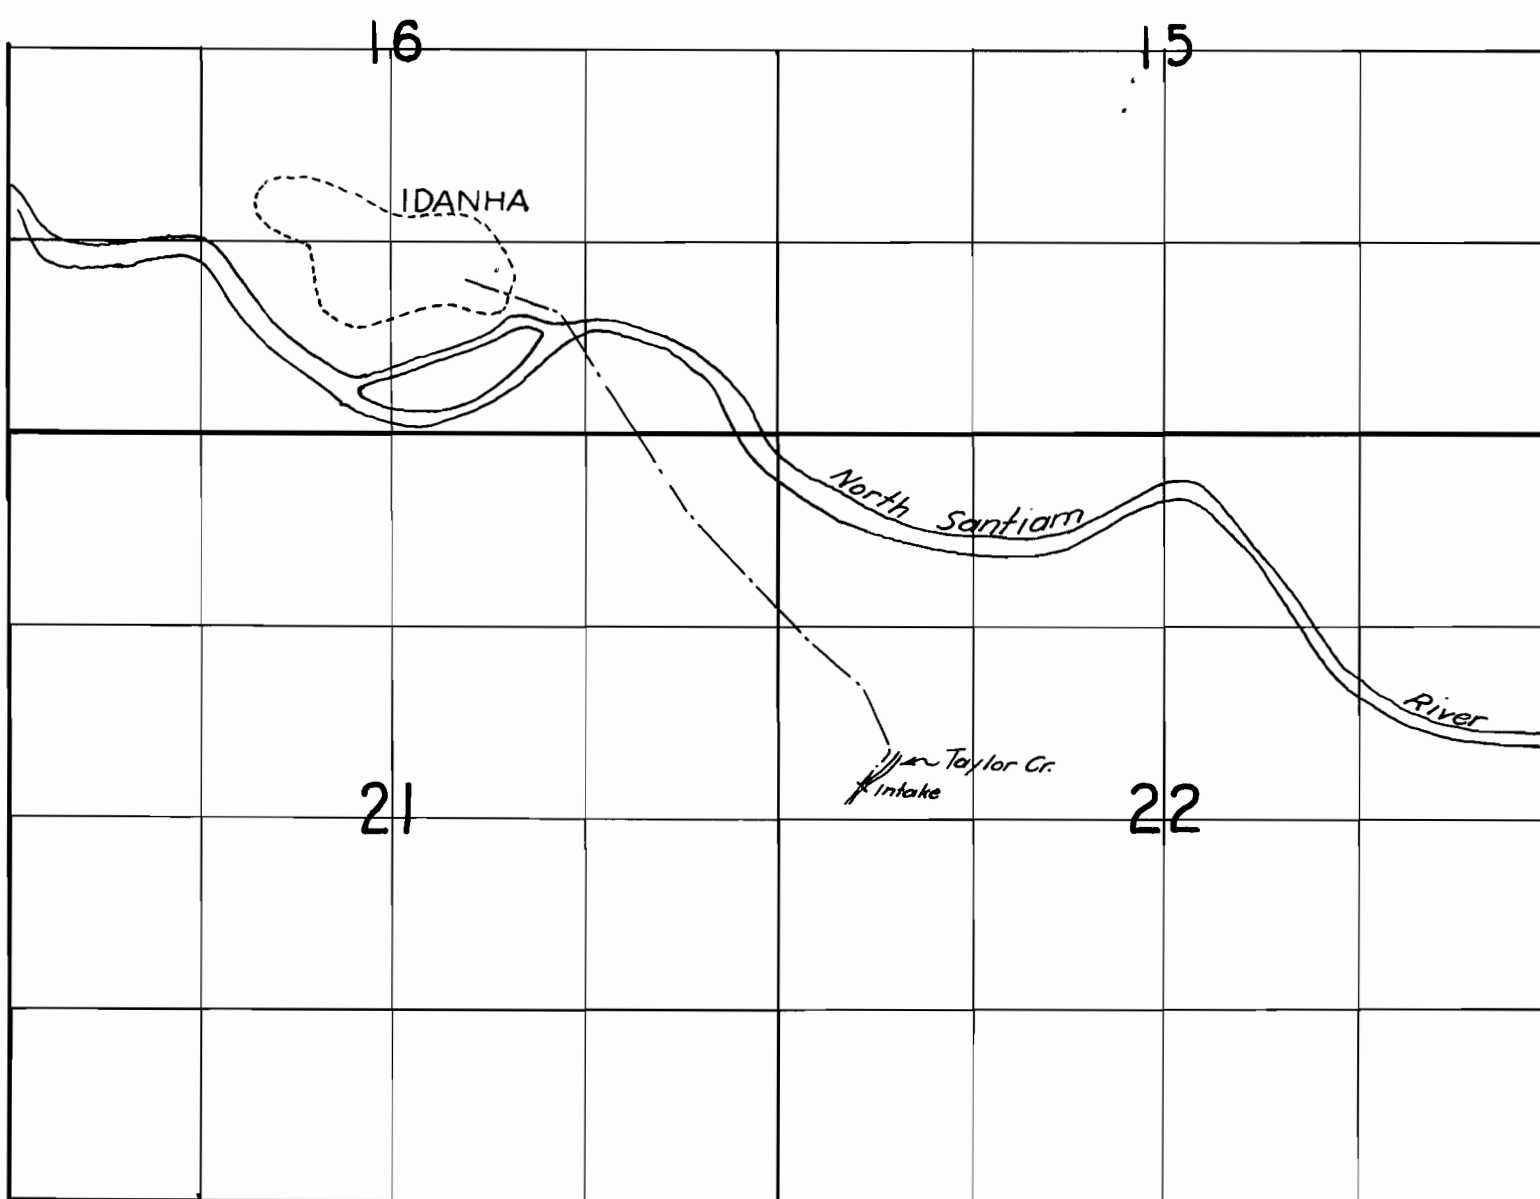

FINAL PROOF SURVEY
UNDER

Application No. 18393 Permit No. 14033

IN NAME OF

C. T. Haseman

Surveyed May 15, 1941, by C. C. Cunningham